

REGISTERED SURVEYOR'S CERTIFICATION
 BELLEVUE ESTATE - STAGE 3
 Saunders Havill Group Pty Ltd, Registered Surveyor, hereby certify that the vertical and horizontal locations and dimensions shown on this plan are a true and correct record and were located by survey.

4611
 Authorised Signatory Reg. Surveyor No. Date

AS CONSTRUCTED CERTIFICATION
 BELLEVUE ESTATE - STAGE 3

(Company's representative Name) (Signature)
 (Date) (RPEQ)
 Being a duly representative of- (Company Name)


Hereby certify that
 1. The information contained in this drawing / document is in compliance with approved drawings and design supplied under the terms of the contract.
 2. This represents an accurate "As constructed" record of works carried out and accept responsibility for the information contained in this drawing / document.

ADAC Verification Plot

Project Name: Bellevue Estate - Stage 3
 Description: Subdivision
 Works Approval ID: 9332/2019/PDA
 Receiver: Ipswich City Council
 Construction date: 2022-01-10
 Status: As Constructed


ADAC version: 5.0.1
 Horizontal coordinates: MGA zone 56 (GDA2020)
 Vertical datum: AHD derived
 Notes: Vertical Origin: PM49894, RL62.35
 Surveyor: Saunders Havill Group (Reg ID 4611)
 Engineer: Peak Urban

Note: See ADAC xml file for full attribute information

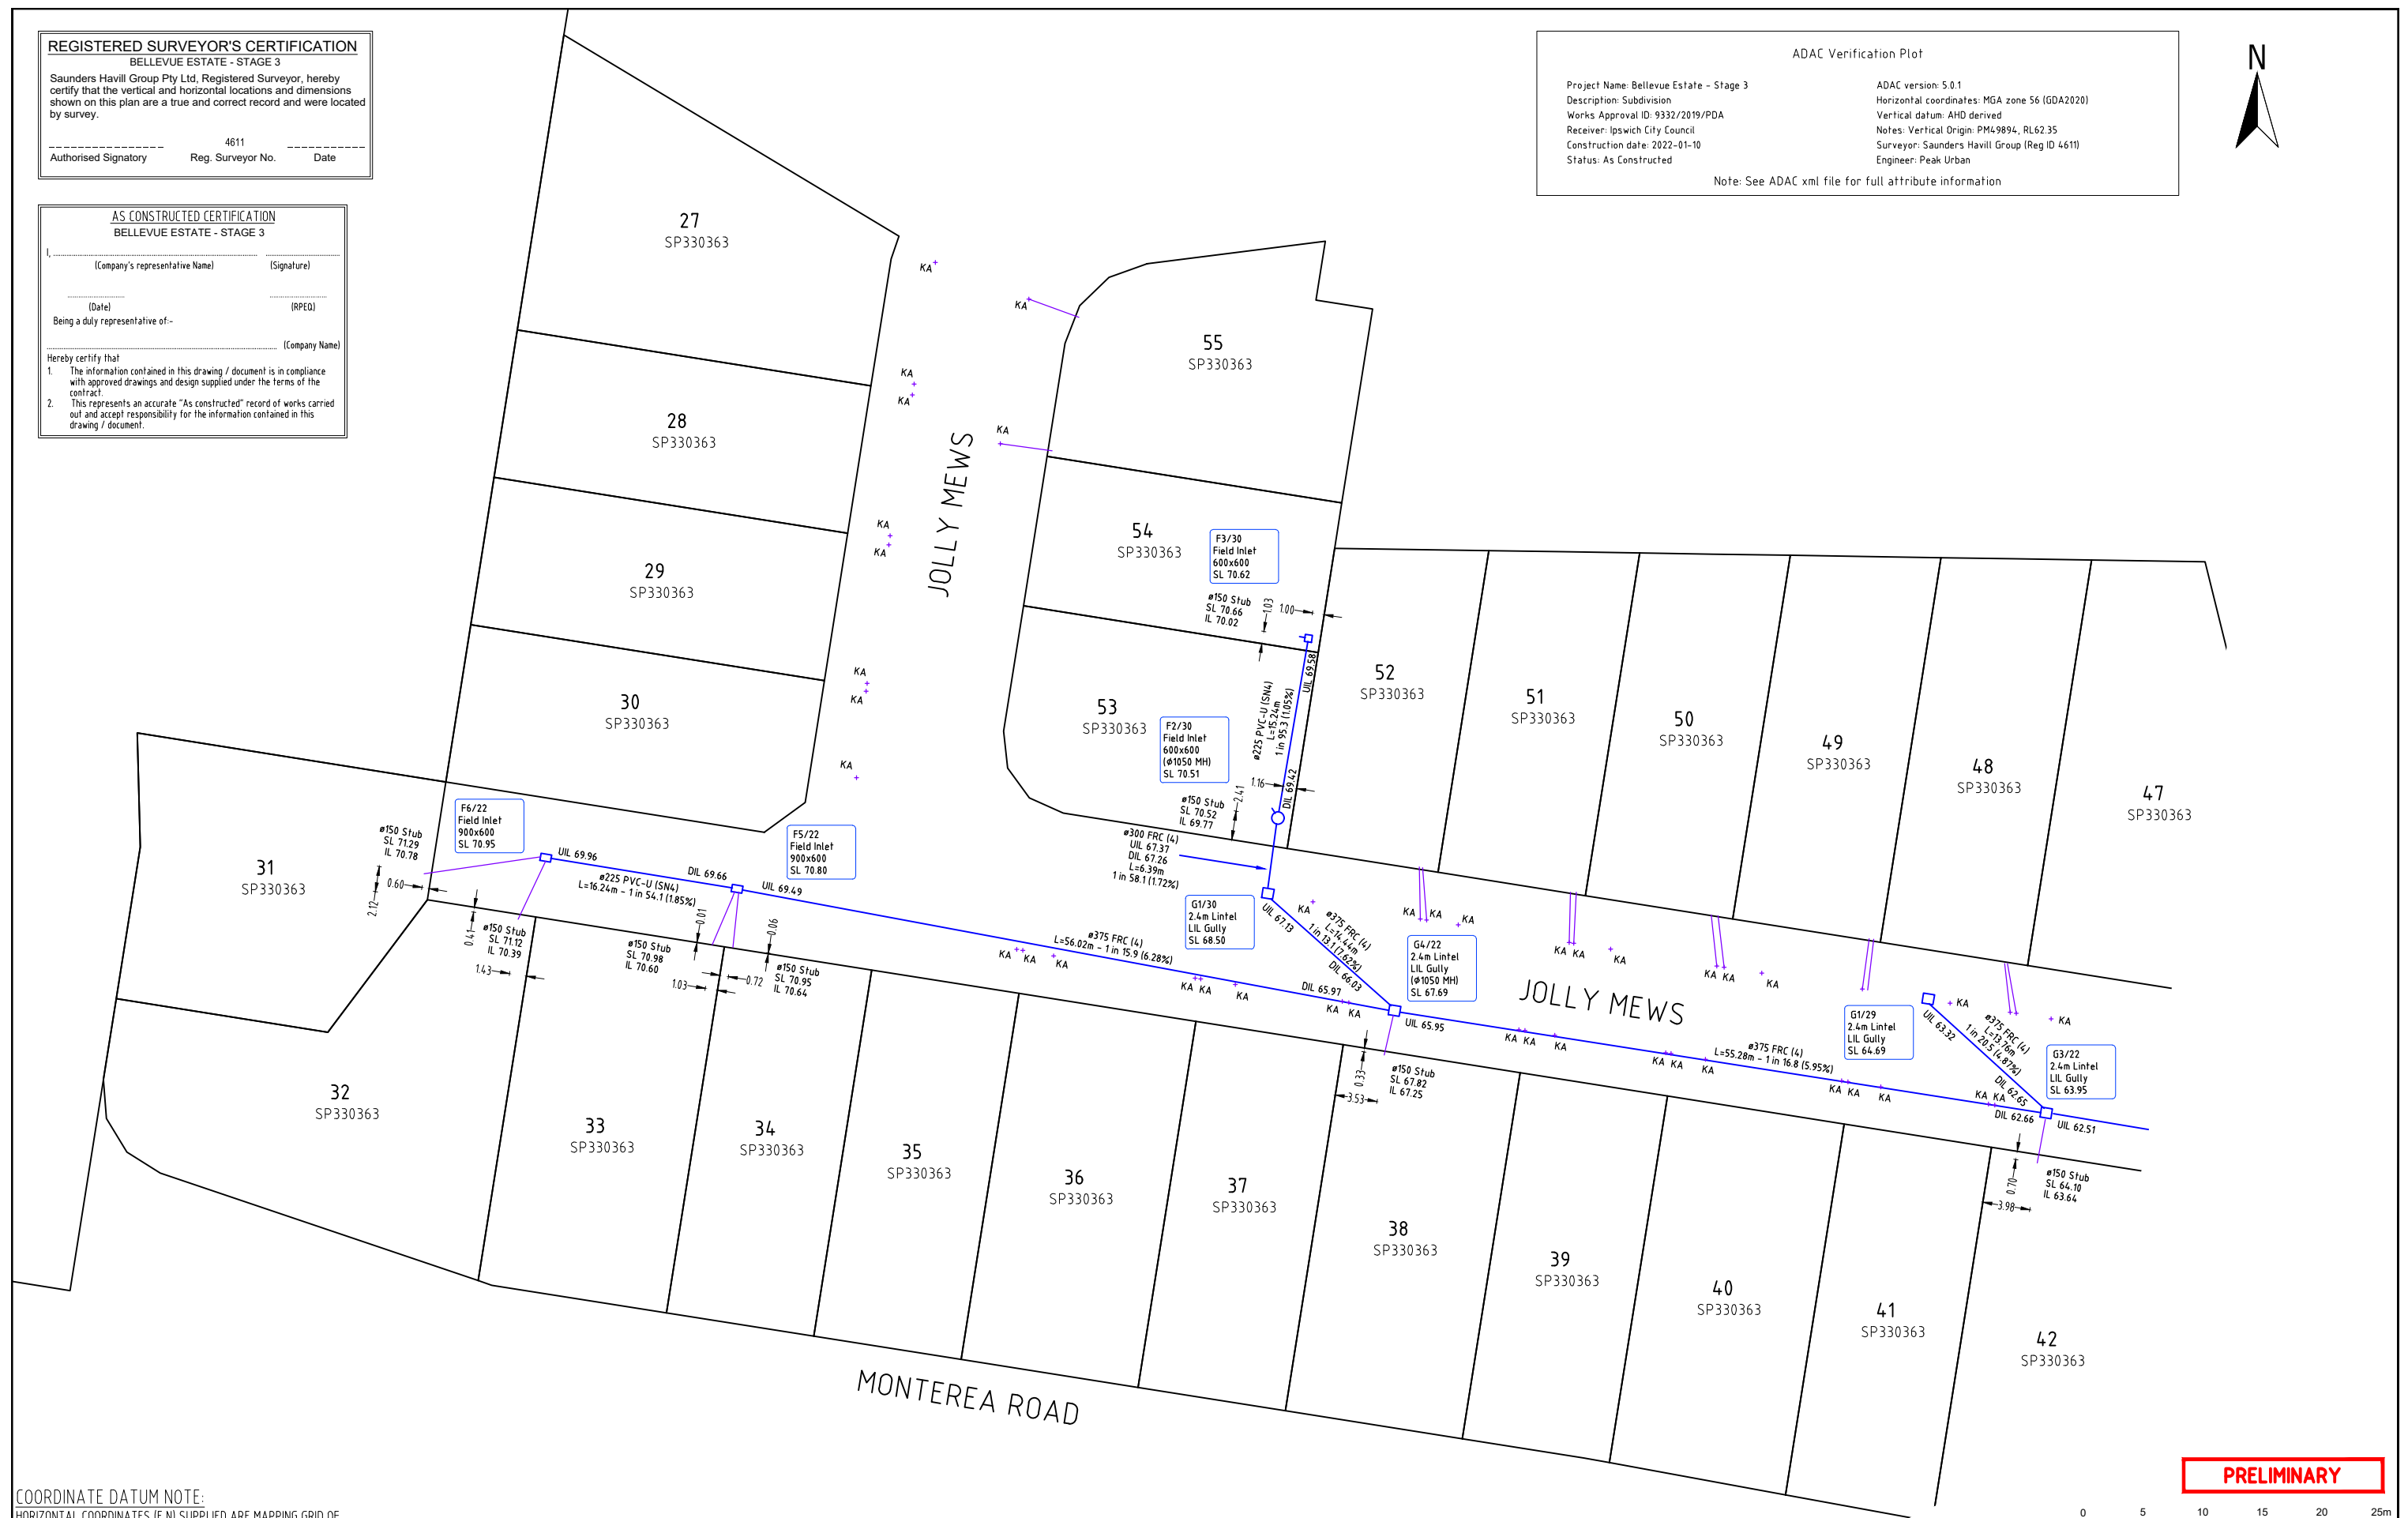

COORDINATE DATUM NOTE:
 HORIZONTAL COORDINATES (E,N) SUPPLIED ARE MAPPING GRID OF AUSTRALIA (MGA), ZONE 56 BASED ON THE UNIVERSAL TRANSVERSE MERCATOR PROJECTION AND THE GEOCENTRIC DATUM OF AUSTRALIA 2020.

PRELIMINARY

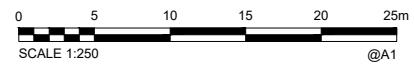

A1	INDEX	DATE	REVISIONS	DRAWN	CHECKED	PASSED
	A	Prelim	Original Issue			

DRAWN	CH	29.09.2022
CHECKED	CU	05.10.2022
PASSED		
INITIALS	DATE	

saunders havill group
 Brisbane Springfield Rockhampton
 head office 9 Thompson St Bowen Hills Q 4006
 phone 1300 423 SHG web www.saundershavill.com
 Drawing No: 9780 S 26 AC A

PEAKURBAN
 Achieve more.
 ENQUIRES@PEAKURBAN.COM.AU

City of Ipswich

IPSWICH CITY COUNCIL
 AS CONSTRUCTED - ROADS & DRAINAGE
 BELLEVUE ESTATE - STAGE 3
 357 RIPLEY ROAD, RIPLEY

SCALE	1:250
SHEET	1 OF 2 SHEETS
DRAWING NO.	

ADAC Verification Plot

Project Name: Bellevue Estate - Stage 3
 Description: Subdivision
 Works Approval ID: 9332/2019/PDA
 Receiver: Ipswich City Council
 Construction date: 2022-01-10
 Status: As Constructed

ADAC version: 5.0.1
 Horizontal coordinates: MGA zone 56 (GDA2020)
 Vertical datum: AHD derived
 Notes: Vertical Origin: PM4-9894, RL62.35
 Surveyor: Saunders Havill Group (Reg ID 4611)
 Engineer: Peak Urban

Note: See ADAC xml file for full attribute information

AS CONSTRUCTED CERTIFICATION
 BELLEVUE ESTATE - STAGE 3


(Company's representative Name) (Signature)
 (Date) (RPEQ)
 Being a duly representative of- (Company Name)

Hereby certify that
 1. The information contained in this drawing / document is in compliance with approved drawings and design supplied under the terms of the contract.
 2. This represents an accurate "As constructed" record of works carried out and accept responsibility for the information contained in this drawing / document.


REGISTERED SURVEYOR'S CERTIFICATION
 BELLEVUE ESTATE - STAGE 3

Saunders Havill Group Pty Ltd, Registered Surveyor, hereby certify that the vertical and horizontal locations and dimensions shown on this plan are a true and correct record and were located by survey.

4611
 Authorised Signatory Reg. Surveyor No. Date

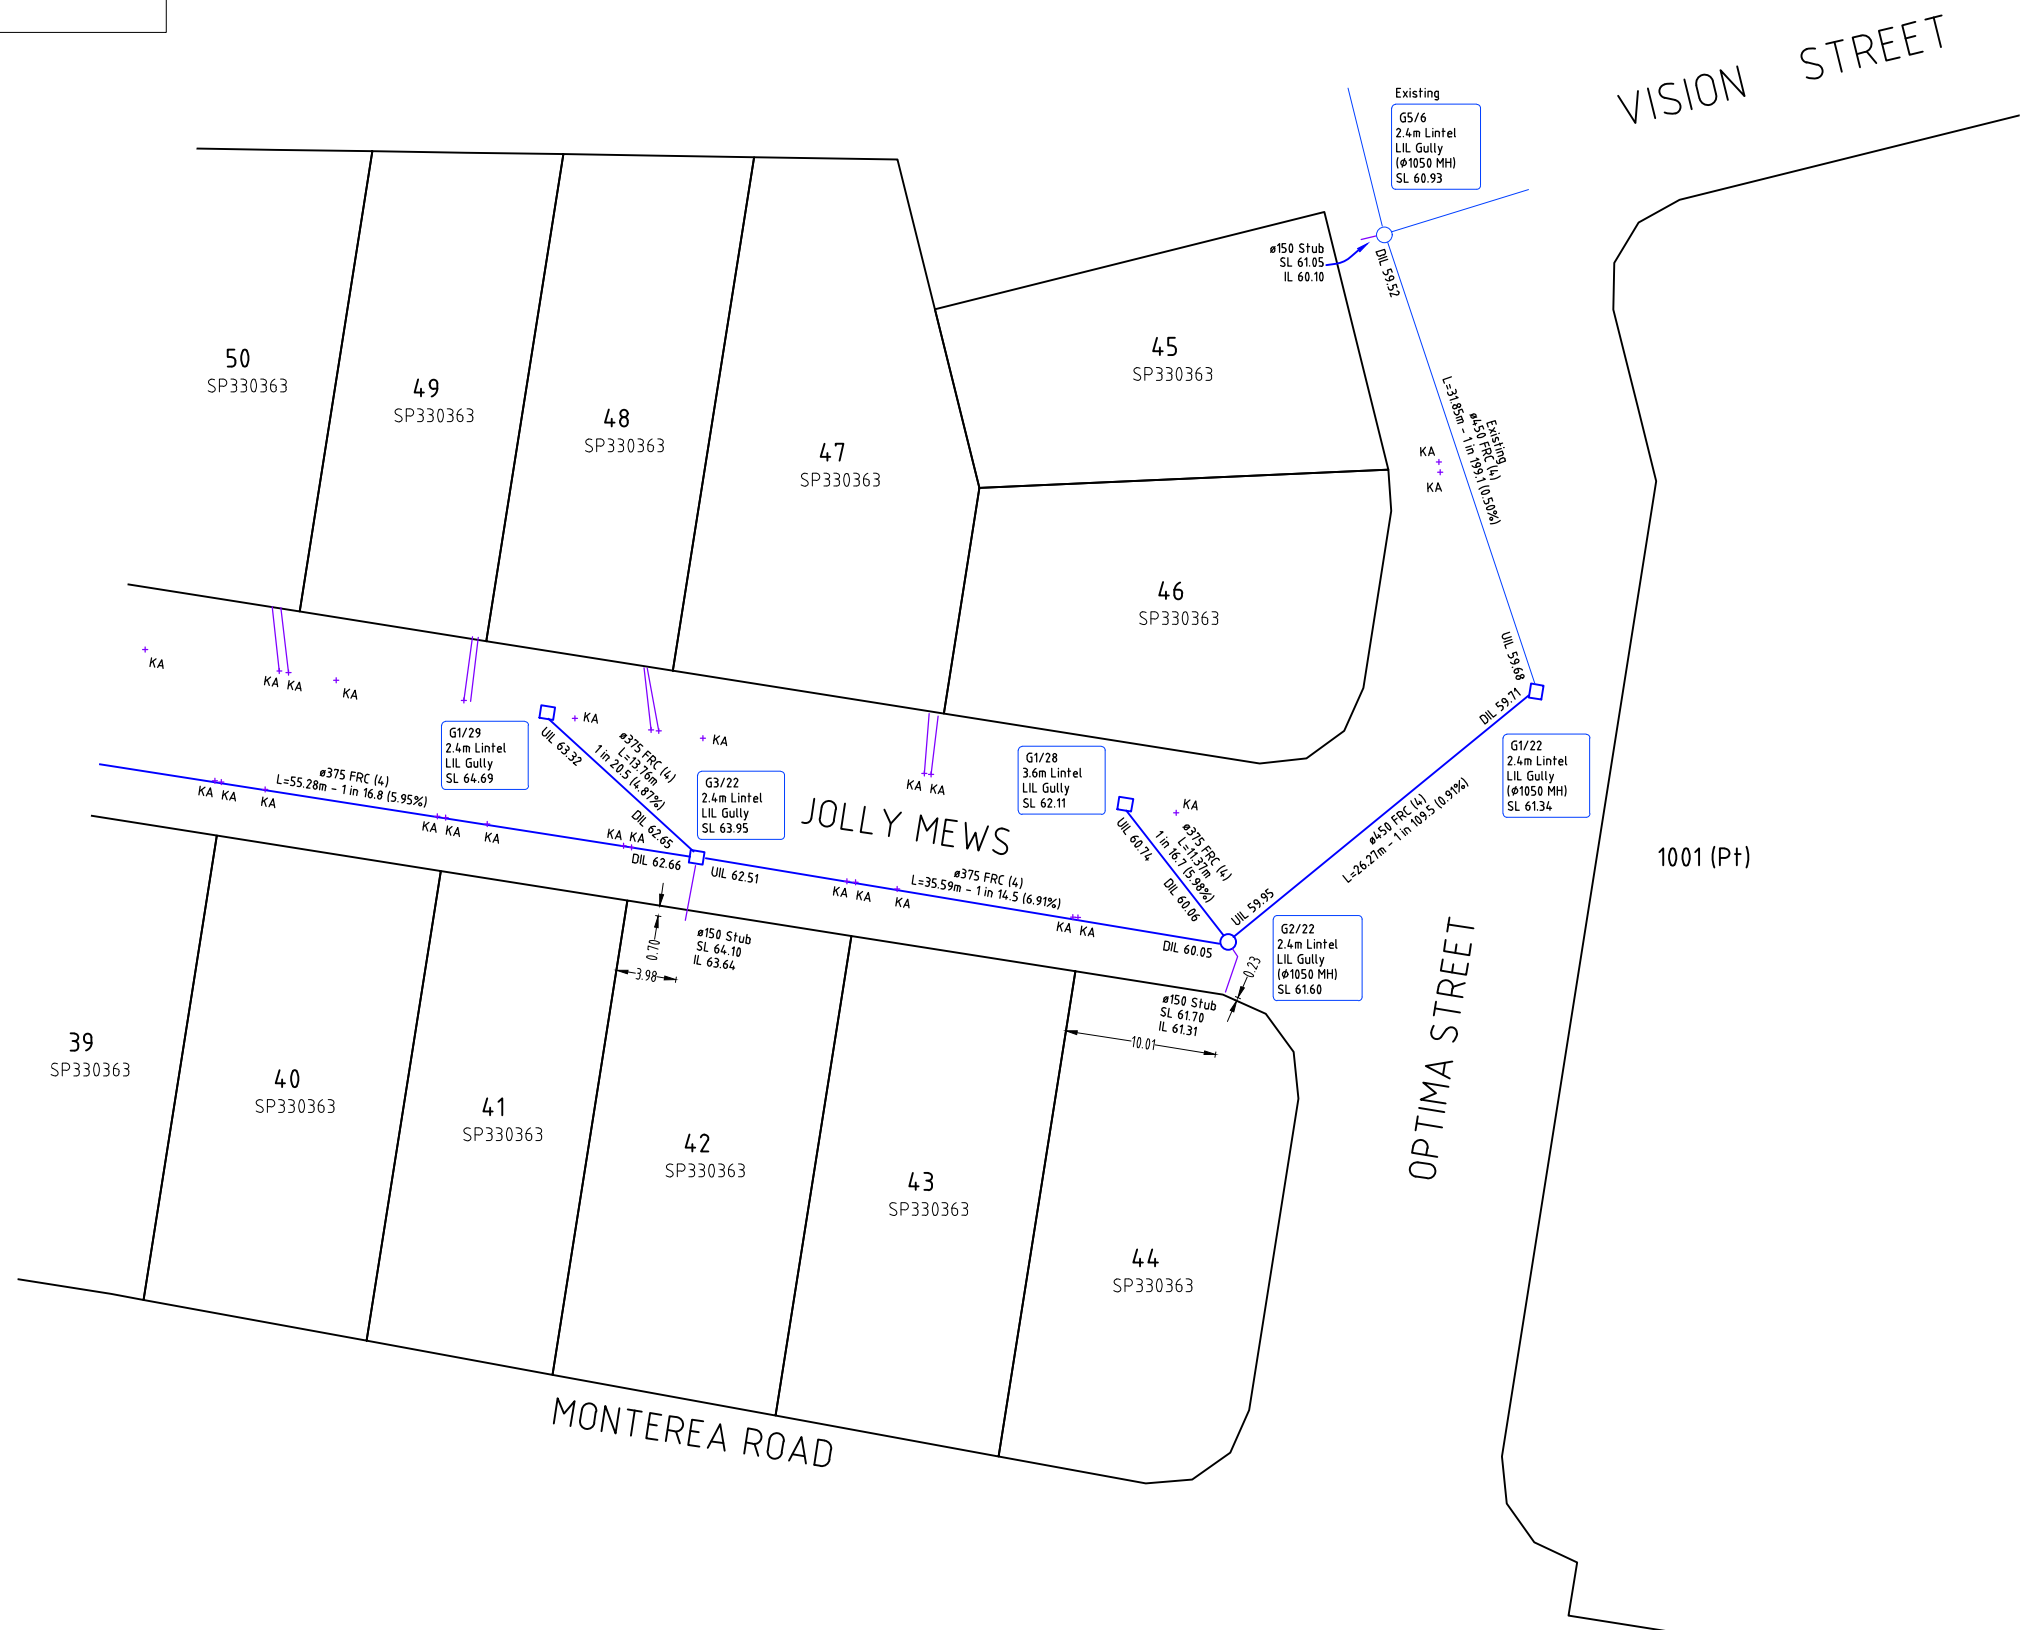

COORDINATE DATUM NOTE:
 HORIZONTAL COORDINATES (E,N) SUPPLIED ARE MAPPING GRID OF AUSTRALIA (MGA), ZONE 56 BASED ON THE UNIVERSAL TRANSVERSE MERCATOR PROJECTION AND THE GEOCENTRIC DATUM OF AUSTRALIA 2020.

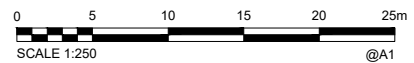

PRELIMINARY

A1	A	Prelim	Original Issue						
	INDEX	DATE	REVISIONS	DRAWN	CHECKED	PASSED	INITIALS	DATE	

saunders havill group
 Brisbane Springfield Rockhampton
 head office 9 Thompson St Bowen Hills Q 4006
 phone 1300 123 SHG web www.saundershavill.com
 Drawing No: 9780 S 26 AC A

PEAKURBAN
 Achieve more.
 ENQUIRES@PEAKURBAN.COM.AU

City of Ipswich

IPSWICH CITY COUNCIL
 AS CONSTRUCTED - ROADS & DRAINAGE
 BELLEVUE ESTATE - STAGE 3
 357 RIPLEY ROAD, RIPLEY

SCALE	1:250
SHEET	2 OF 2 SHEETS
DRAWING NO.	