


All house connections are $\phi 110$ unless otherwise noted.

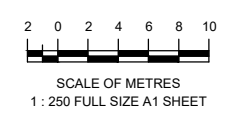

A1

REV NO	DATE	REVISION PURPOSE / DESCRIPTION	DRAWN	RPEQ	RPEQ No
A	08.06.2023	Original Issue			


DRAWN	CM	01.06.2023
CHECKED	CU	08.06.2023
APPROVED		

SH saunders havill group
 Saunders Havill Group Pty Ltd ABN 24 144 592 540
 head office 5 Thompson St Bowen Hills Q 4006
 phone 090 83 5HG web www.saundershavill.com
 ■ surveying ■ town planning ■ urban design ■ environmental management ■ landscape architecture
 Drawing No: 9780 S 37 AC A


BELLEVUE RIPLEY

BELLEVUE ESTATE - STAGE 6
LIVELY STREET, RIPLEY
BUILDERS SKETCH
SEWERAGE RETICULATION 21-PNT-54785

DRAWING STATUS AS CONSTRUCTED	
SHEET 1 OF 2 SHEETS	
DRAWING NO.	REV.
	A

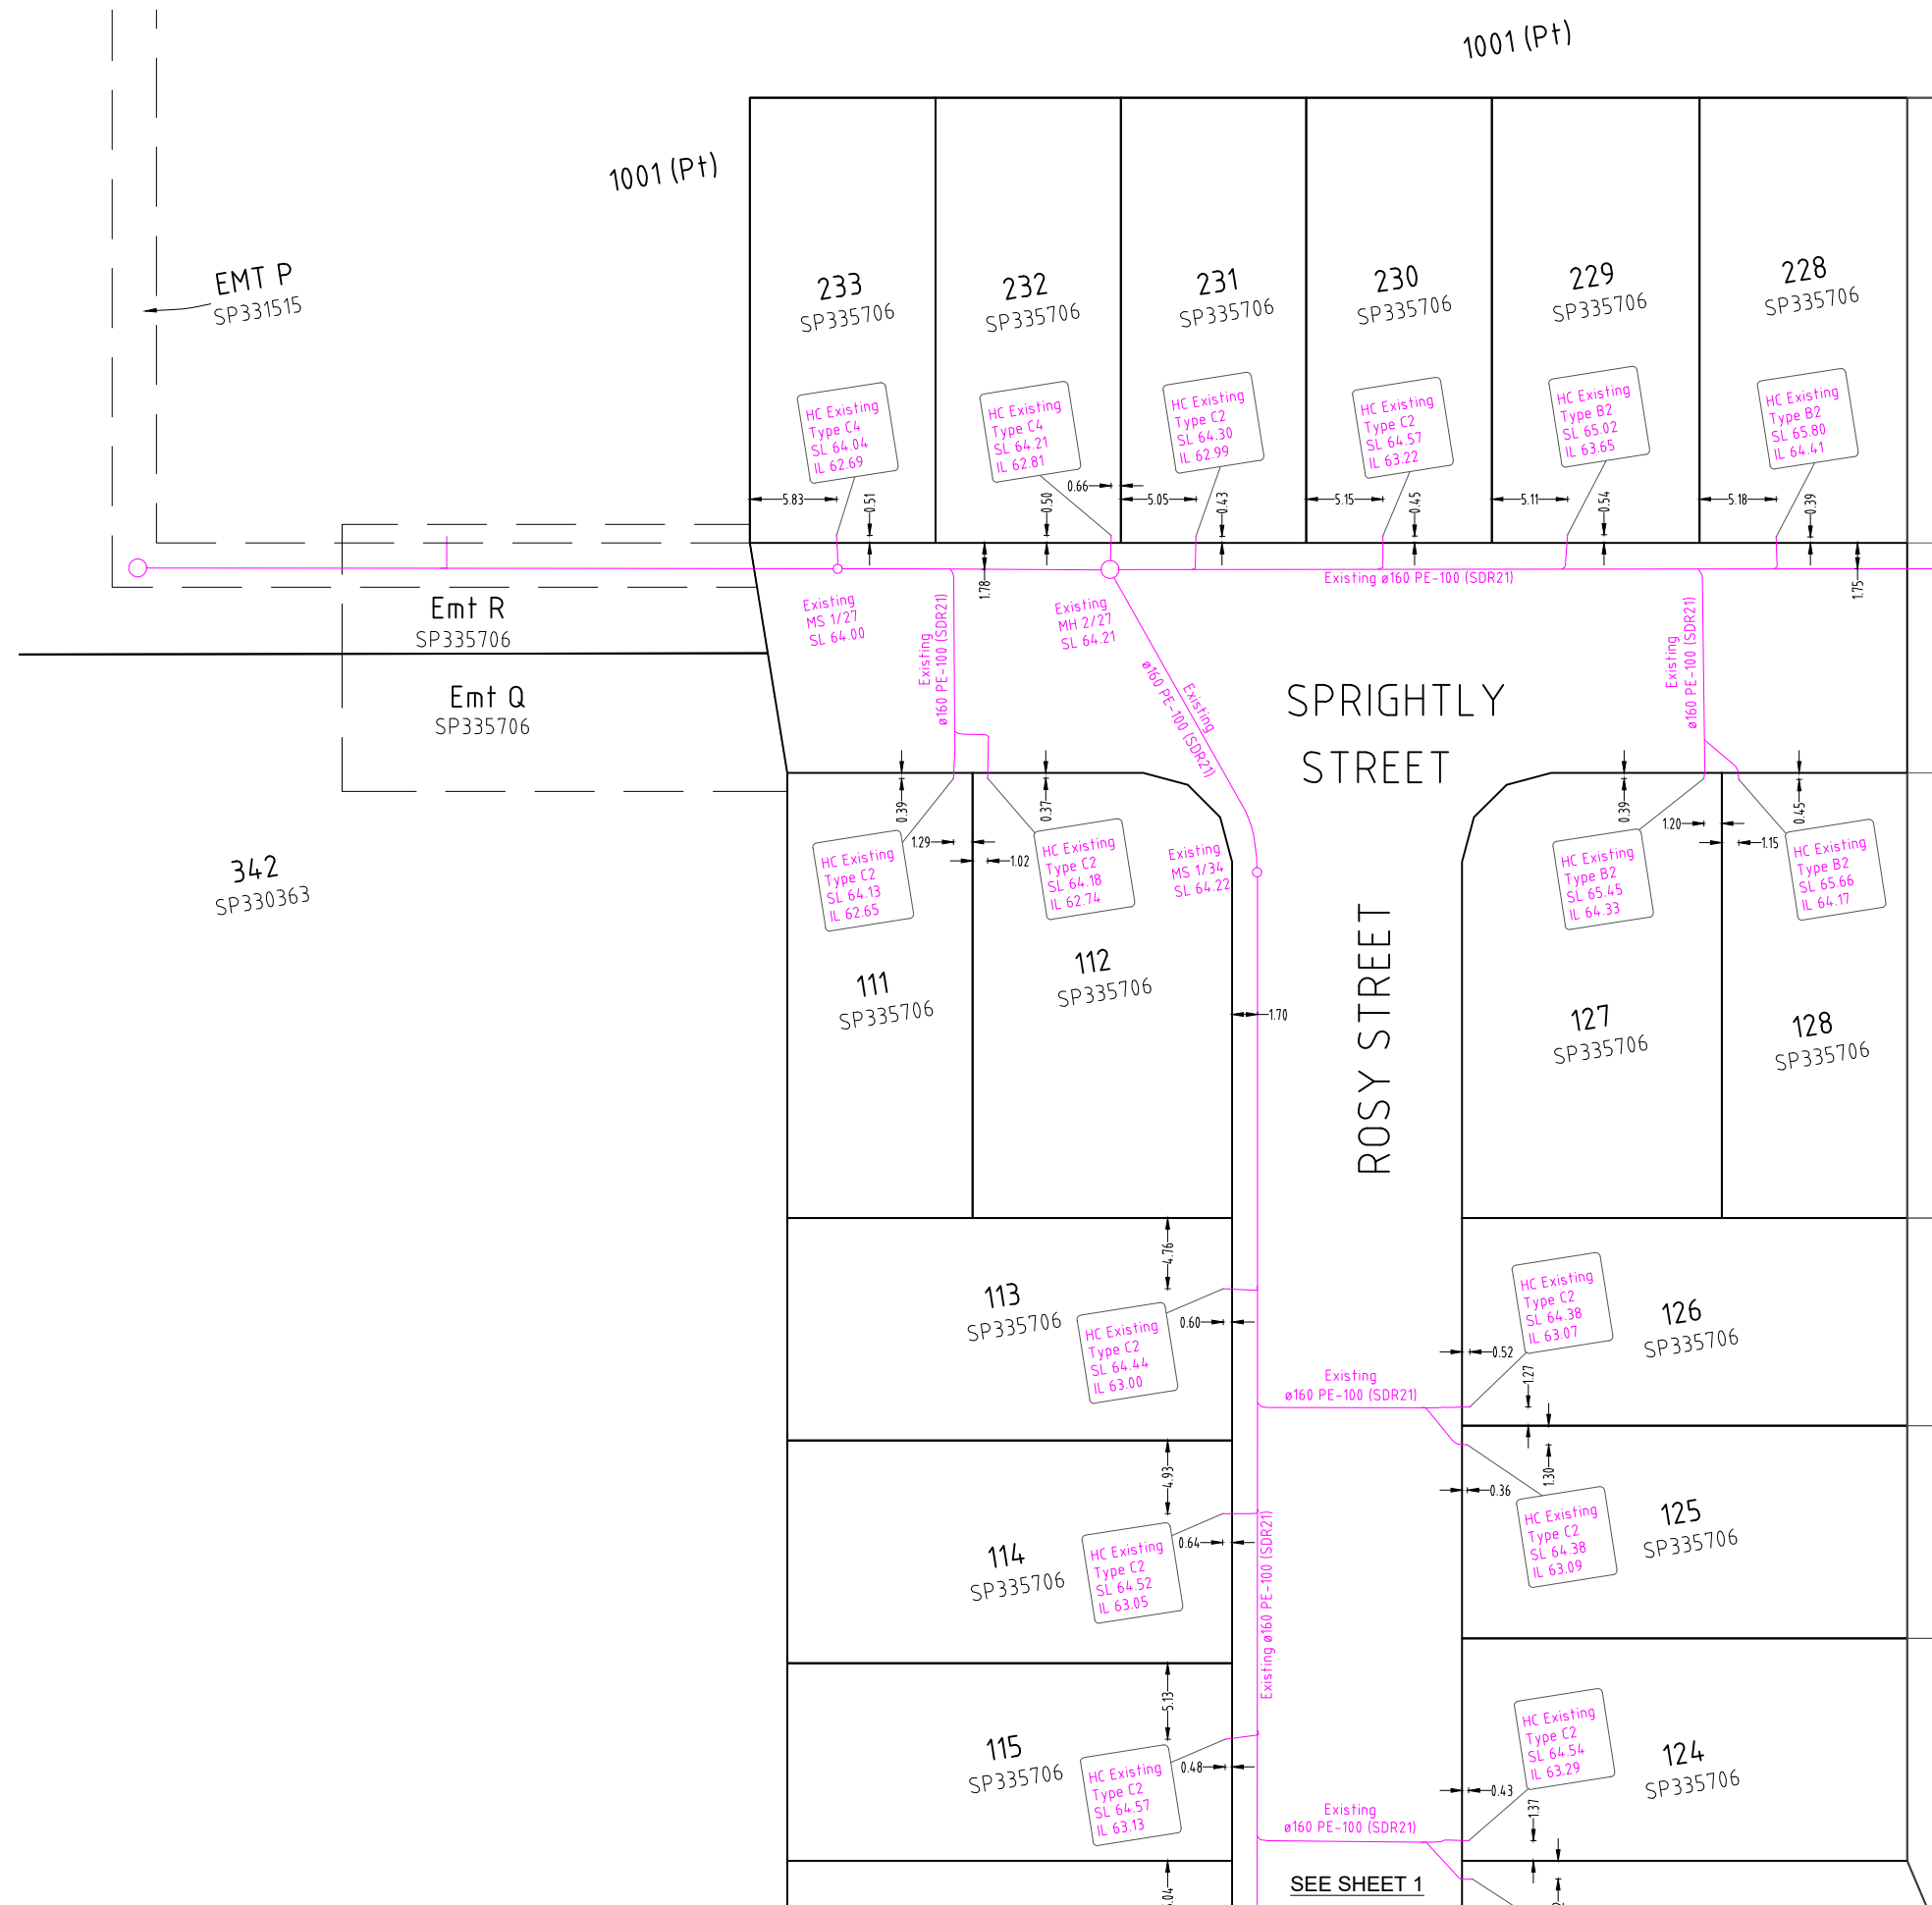

All house connections are ø110 unless otherwise noted.

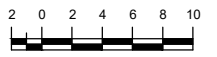

SCALE OF METRES
1 : 250 FULL SIZE A1 SHEET

A1

REV NO	DATE	REVISION PURPOSE / DESCRIPTION	DRAWN	RPEQ	RPEQ No	INITIALS	DATE
A	08.06.2023	Original Issue					

DRAWN	CM	01.06.2023
CHECKED	CU	08.06.2023
APPROVED		

SH saunders havill group
 Saunders Havill Group Pty Ltd ABN 24 144 592 540
 Brisbane, Springfield
 head office 9 Thompson St Bowen Hills Q 4006
 phone 090 63 5HG web www.saundershavill.com
 ■ surveying ■ town planning ■ urban design ■ environmental management ■ landscape architecture
 Drawing No: 9780 S 37 AC A


BELLEVUE RIPLEY

BELLEVUE ESTATE - STAGE 6
LIVELY STREET, RIPLEY
BUILDERS SKETCH
SEWERAGE RETICULATION 21-PNT-54785

DRAWING STATUS AS CONSTRUCTED	
SHEET 2 OF 2 SHEETS	
DRAWING NO.	REV. A



	Hydrant
	Valve
	Dead End Cap
	Reducer
	Water Meter
	Conduit Crossing and Service Pipe

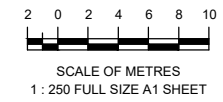

A1

REV NO	DATE	REVISION PURPOSE / DESCRIPTION	DRAWN	RPEQ	RPEQ No
A	08.06.2023	Original Issue			


DRAWN	CM	01.06.2023
CHECKED	CU	08.06.2023
APPROVED		

SH saunders havill group
 Saunders Havill Group Pty Ltd ABN 24 144 592 540
 head office 51 Thompson St Bowen Hills Q 4006
 phone: 0800 623 514 web: www.saundershavill.com
 ■ surveying ■ town planning ■ urban design ■ environmental management ■ landscape architecture
 Drawing No: 9780 S 37 AC A


BELLEVUE
RIPLEY

BELLEVUE ESTATE - STAGE 6
LIVELY STREET, RIPLEY
BUILDERS SKETCH
WATER RETICULATION 21-PNT-54785

DRAWING STATUS AS CONSTRUCTED	
SHEET 1 OF 2 SHEETS	
DRAWING NO.	REV. A

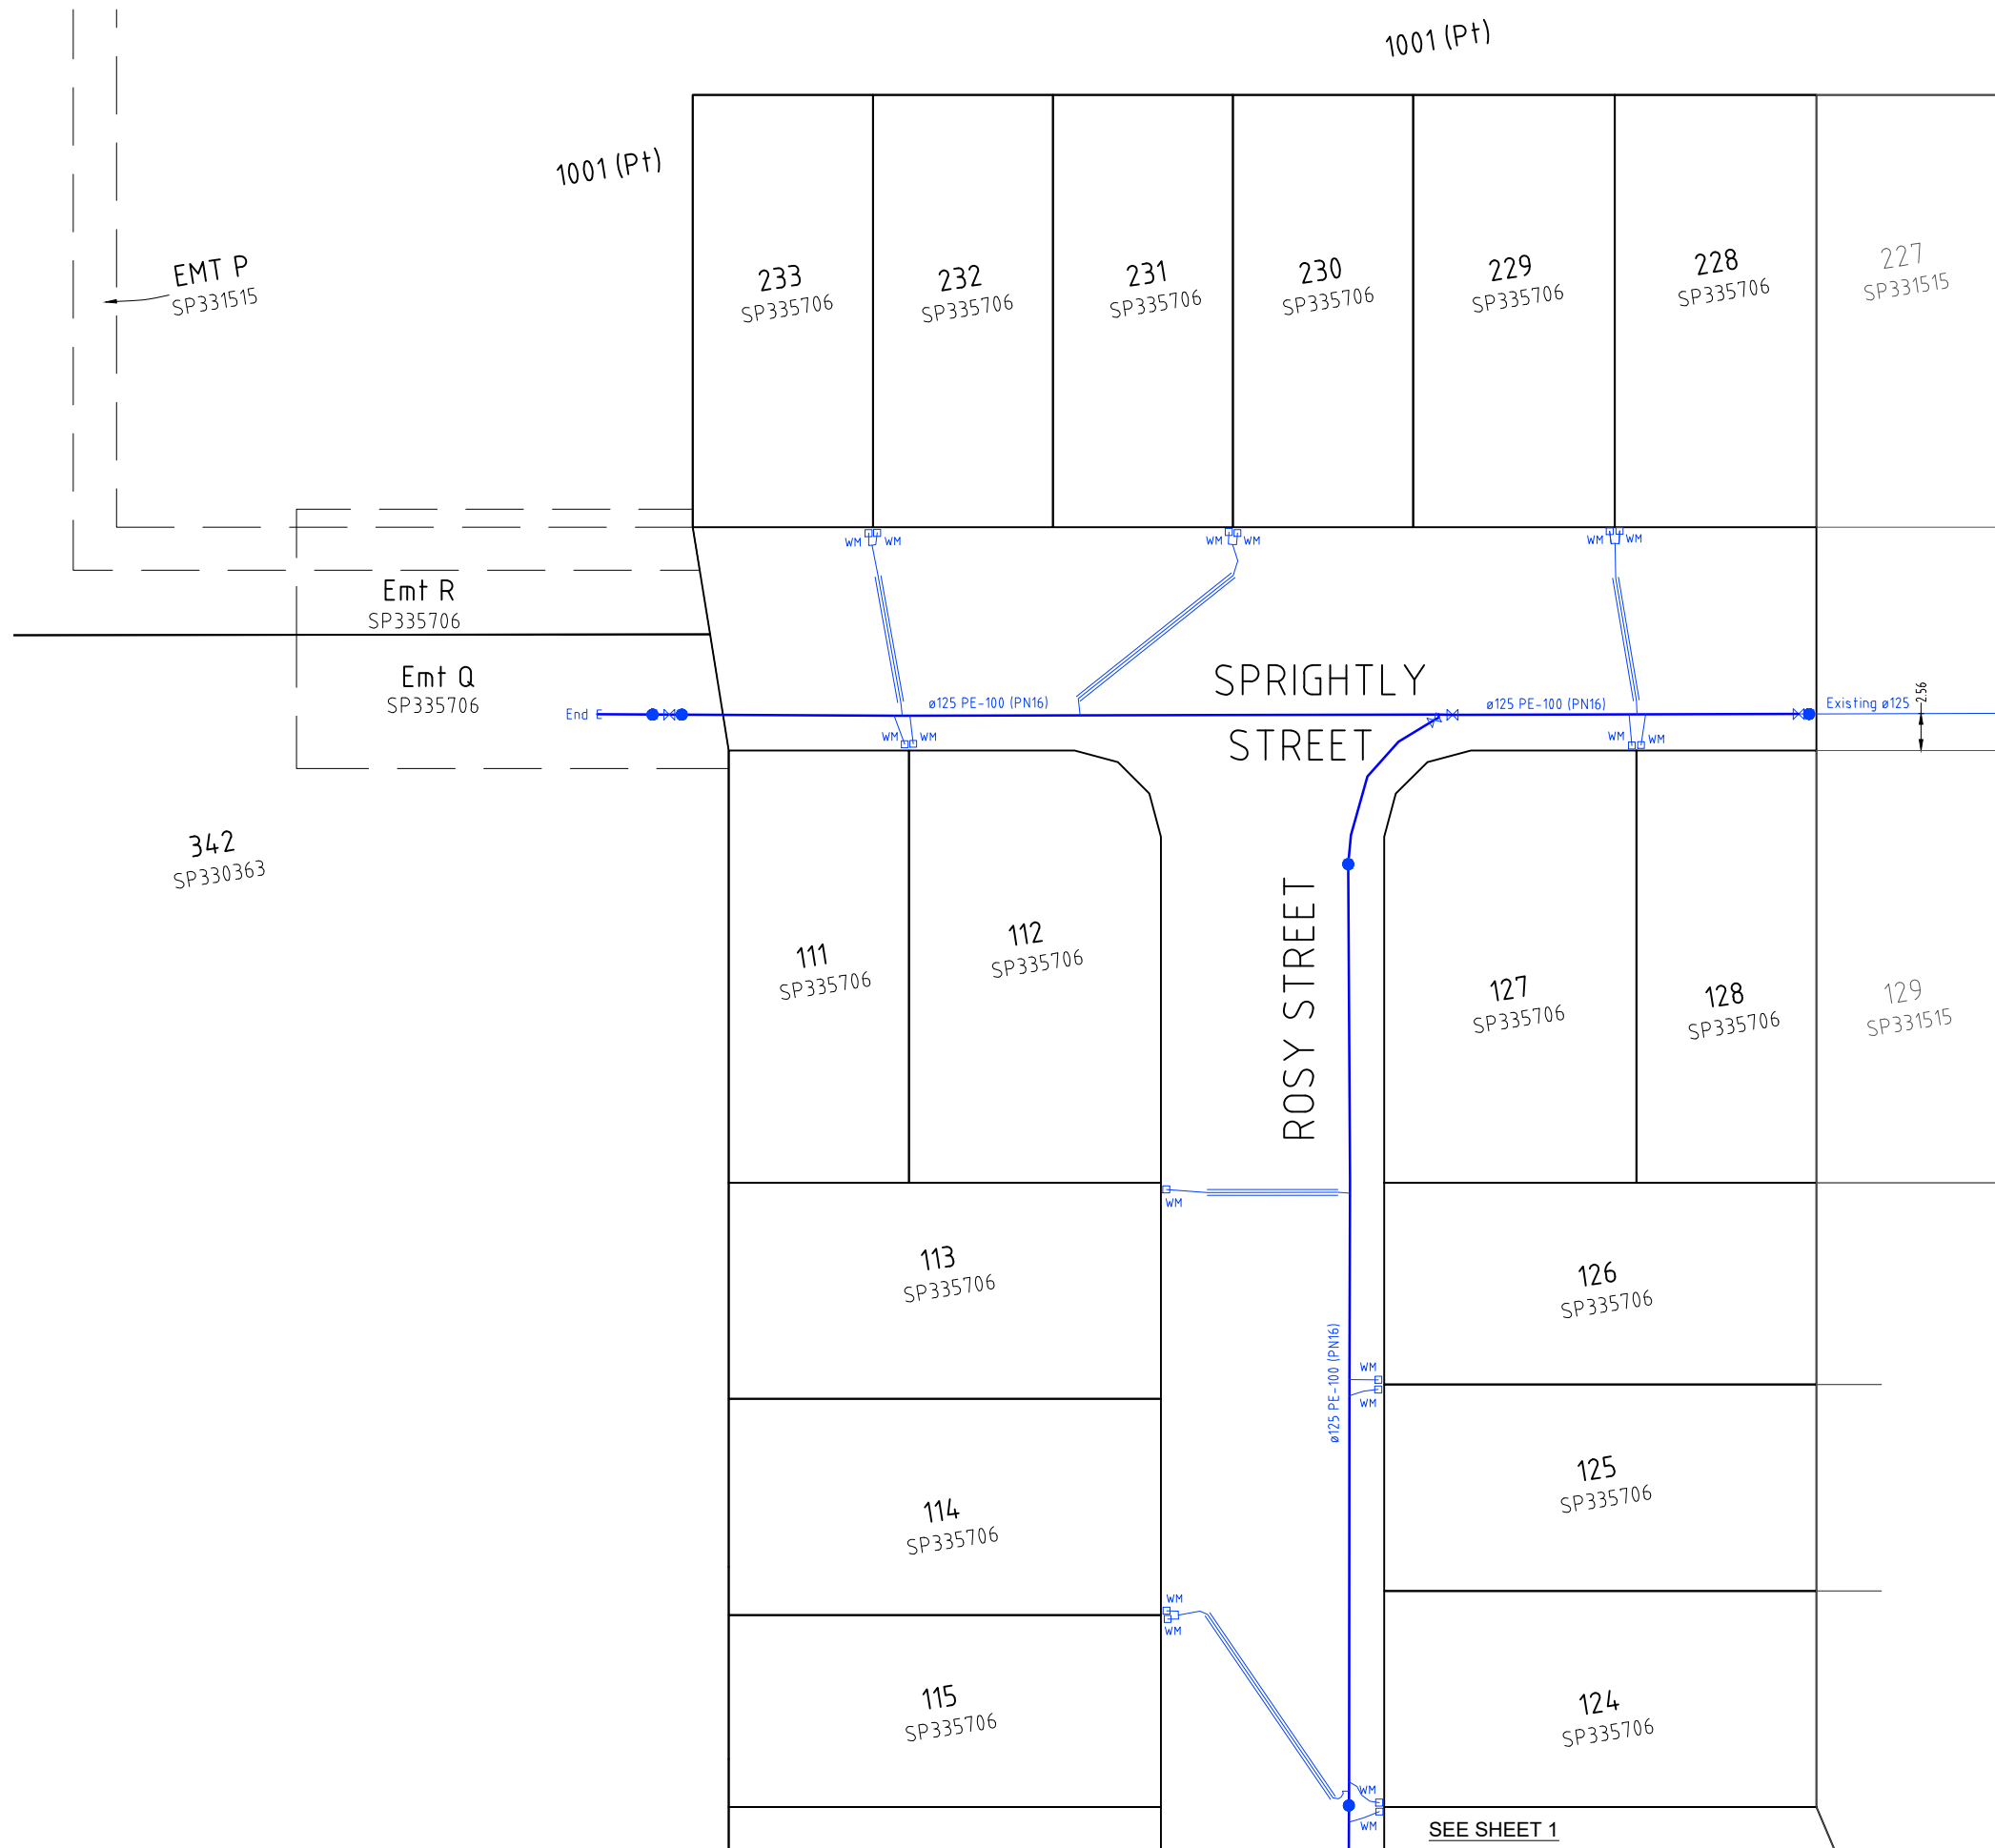

WATER FITTINGS LEGEND	
	Hydrant
	Valve
	Dead End Cap
	Reducer
	Water Meter
	Conduit Crossing and Service Pipe

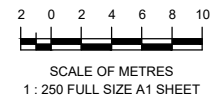

A1

REV NO	DATE	REVISION PURPOSE / DESCRIPTION	DRAWN	RPEQ	RPEQ No	INITIALS	DATE
A	08.06.2023	Original Issue					

DRAWN	CM	01.06.2023
CHECKED	CU	08.06.2023
APPROVED		

saunders havill group
 Saunders Havill Group Pty Ltd ABN 24 144 572 540
 head office 9 Thompson St Bowen Hills Q 4006
 phone: 0800 633 516 web: www.saundershavill.com
 ■ surveying ■ town planning ■ urban design ■ environmental management ■ landscape architecture
 Drawing No: 9780 S 37 AC A


BELLEVUE
RIPLEY

BELLEVUE ESTATE - STAGE 6
LIVELY STREET, RIPLEY
BUILDERS SKETCH
WATER RETICULATION 21-PNT-54785

DRAWING STATUS	
AS CONSTRUCTED	
SHEET 2 OF 2 SHEETS	
DRAWING NO.	REV.
	A



AS CONSTRUCTED

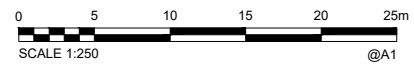

A1

INDEX	DATE	REVISIONS	DRAWN	CHECKED	PASSED
A	08.06.2023	Original Issue			


INITIALS	DATE
DRAWN CM	07.06.2023
CHECKED CU	08.06.2023
PASSED	

SH saunders havill group
 Brisbane Springfield Rockhampton
 head office 9 Thompson St Bowen Hills Q 4006
 phone 1300 123 SHG web www.saundershavill.com
 Drawing No: 9780 S 38 AC A



**BUILDERS SKETCH - DRAINAGE
 BELLEVUE ESTATE - STAGE 6
 357 RIPLEY ROAD, RIPLEY**

SCALE	1:250
SHEET	1 OF 2 SHEETS
DRAWING NO.	

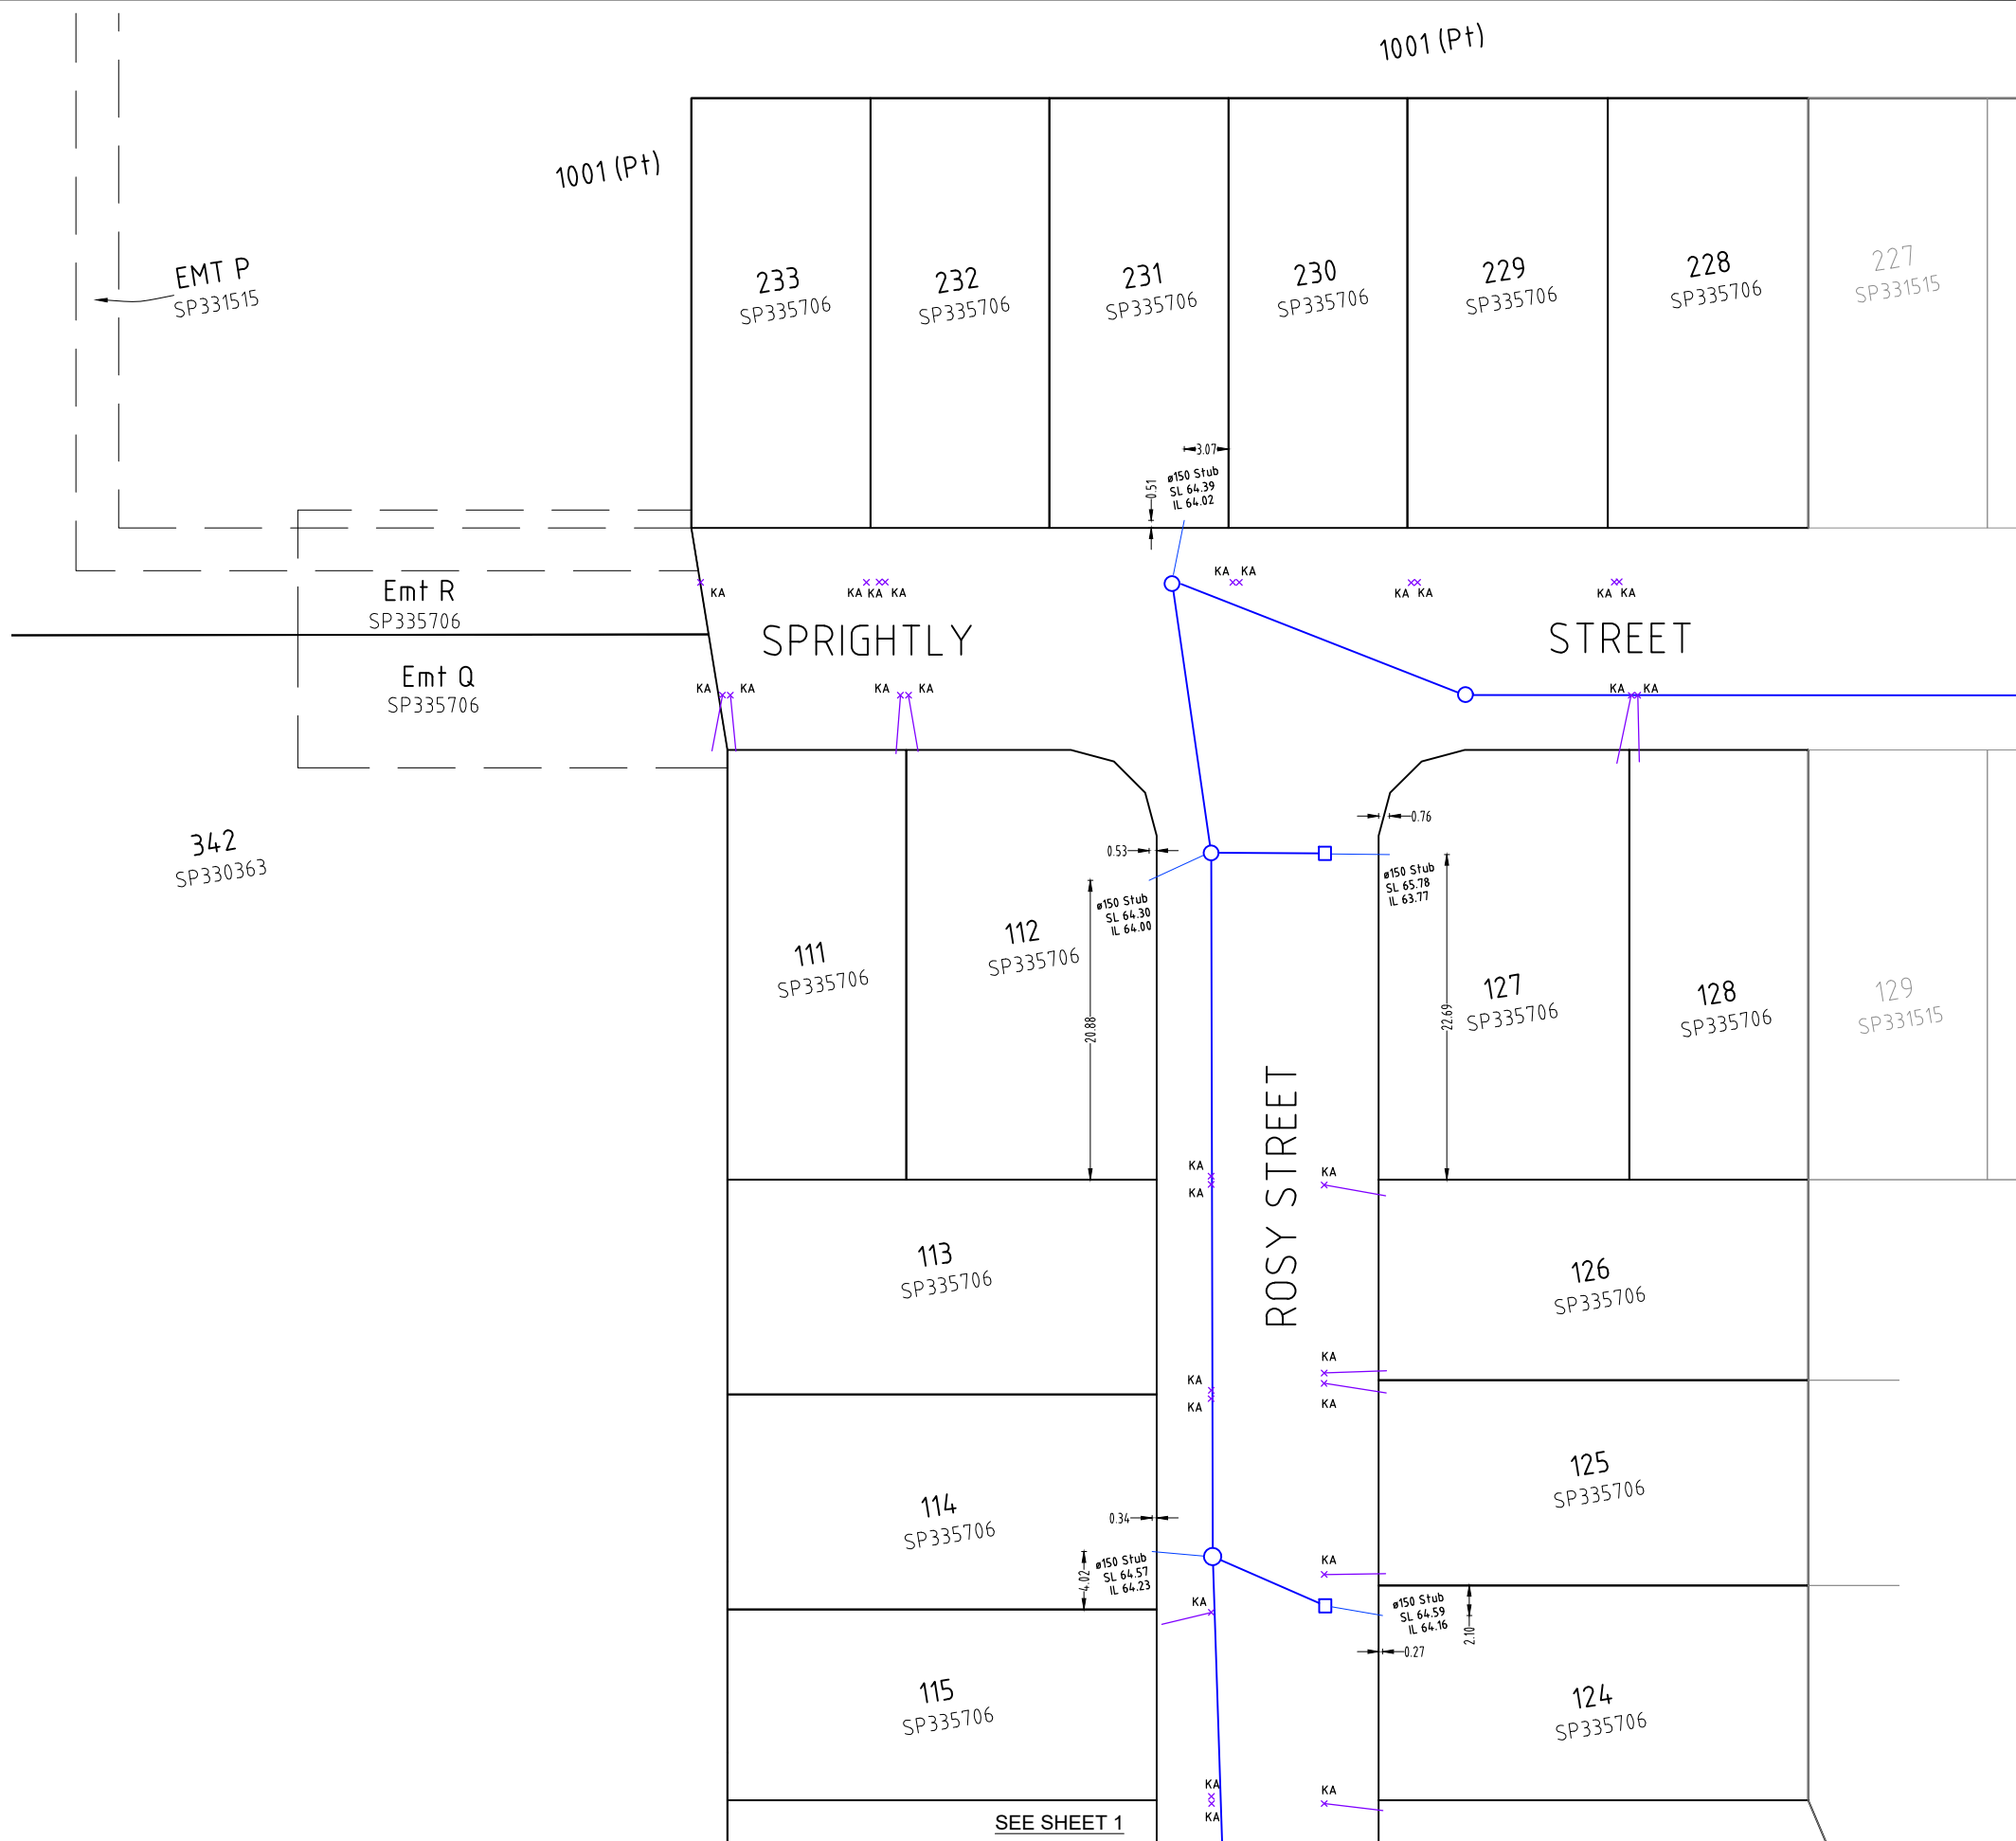

EMT P
SP331515

Emt R
SP335706

Emt Q
SP335706

342
SP330363

233
SP335706

232
SP335706

231
SP335706

230
SP335706

229
SP335706

228
SP335706

227
SP331515

111
SP335706

112
SP335706

127
SP335706

128
SP335706

129
SP331515

113
SP335706

126
SP335706

114
SP335706

125
SP335706

115
SP335706

124
SP335706

SEE SHEET 1

AS CONSTRUCTED



A1

INDEX	DATE	REVISIONS	DRAWN	CHECKED	PASSED
A	08.06.2023	Original Issue			

DRAWN	CM	07.06.2023
CHECKED	CU	08.06.2023
PASSED		

SH saunders havill group
 Brisbane Springfield Rockhampton
 head office 9 Thompson St Bowen Hills Q 4006
 phone 1300 423 SHG web www.saundershavill.com
 Drawing No: 9780 S 38 AC A



BUILDERS SKETCH - DRAINAGE
 BELLEVUE ESTATE - STAGE 6
 357 RIPLEY ROAD, RIPLEY

SCALE	1:250
SHEET	2 OF 2 SHEETS
DRAWING NO.	