






SEE SHEET 1

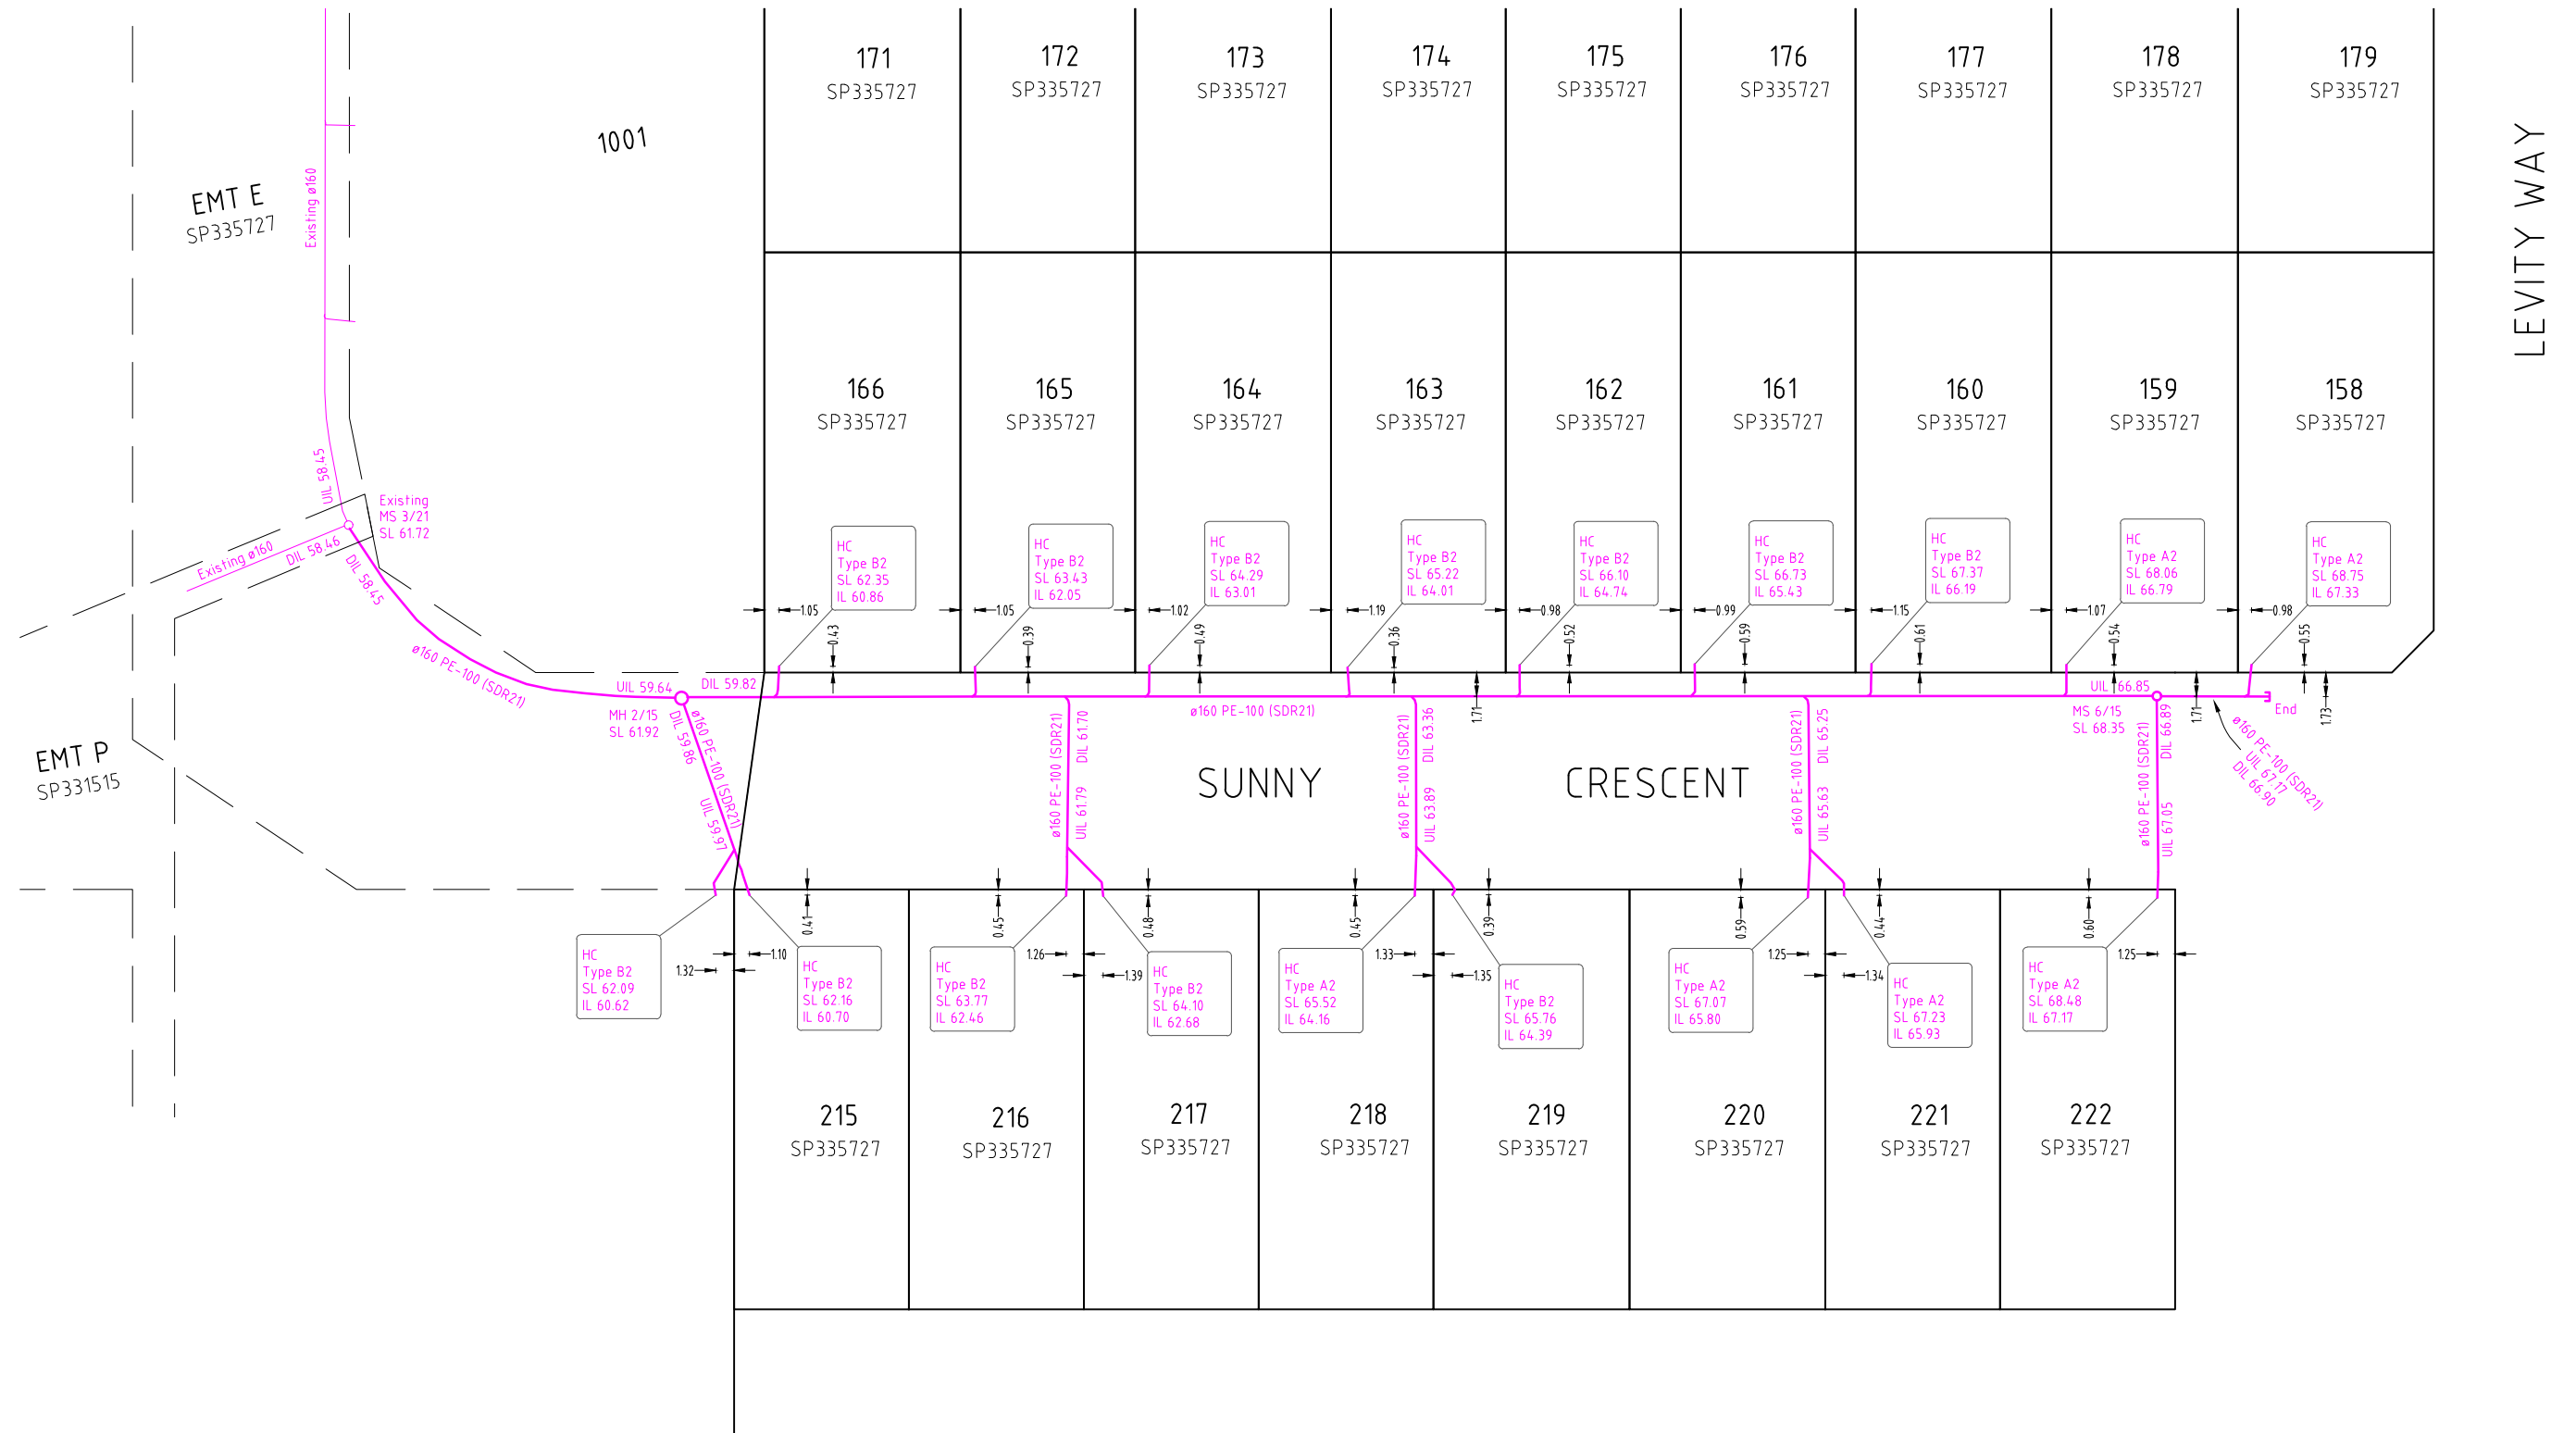

All house connections are ø110 unless otherwise noted.



SCALE OF METRES  
1 : 250 FULL SIZE A1 SHEET

A1

REV NO	DATE	REVISION PURPOSE / DESCRIPTION	DRAWN	RPEQ	RPEQ No
A	25.07.2023	Builders Issue			

DRAWN	CM	20.07.2023
CHECKED	CU	21.07.2023
APPROVED		

**saunders havill group**  
 Saunders Havill Group Pty Ltd ABN 54 144 572 540  
 head office 9 Thompson St Bowen Hills Q 4006  
 phone 090 433 5142 web www.saundershavill.com  
 ■ surveying ■ town planning ■ urban design ■ environmental management ■ landscape architecture  
 Drawing No: 9780 S 44 AC A




BELLEVUE ESTATE - STAGE 7  
 357 RIPLEY ROAD  
 PLAN OF ADAC SURVEY DATA  
 SEWERAGE RETICULATION 22-PNT-60099

DRAWING STATUS <b>AS CONSTRUCTED</b>	
SHEET 2 OF 2 SHEETS	
DRAWING NO.	REV. A






SEE SHEET 1

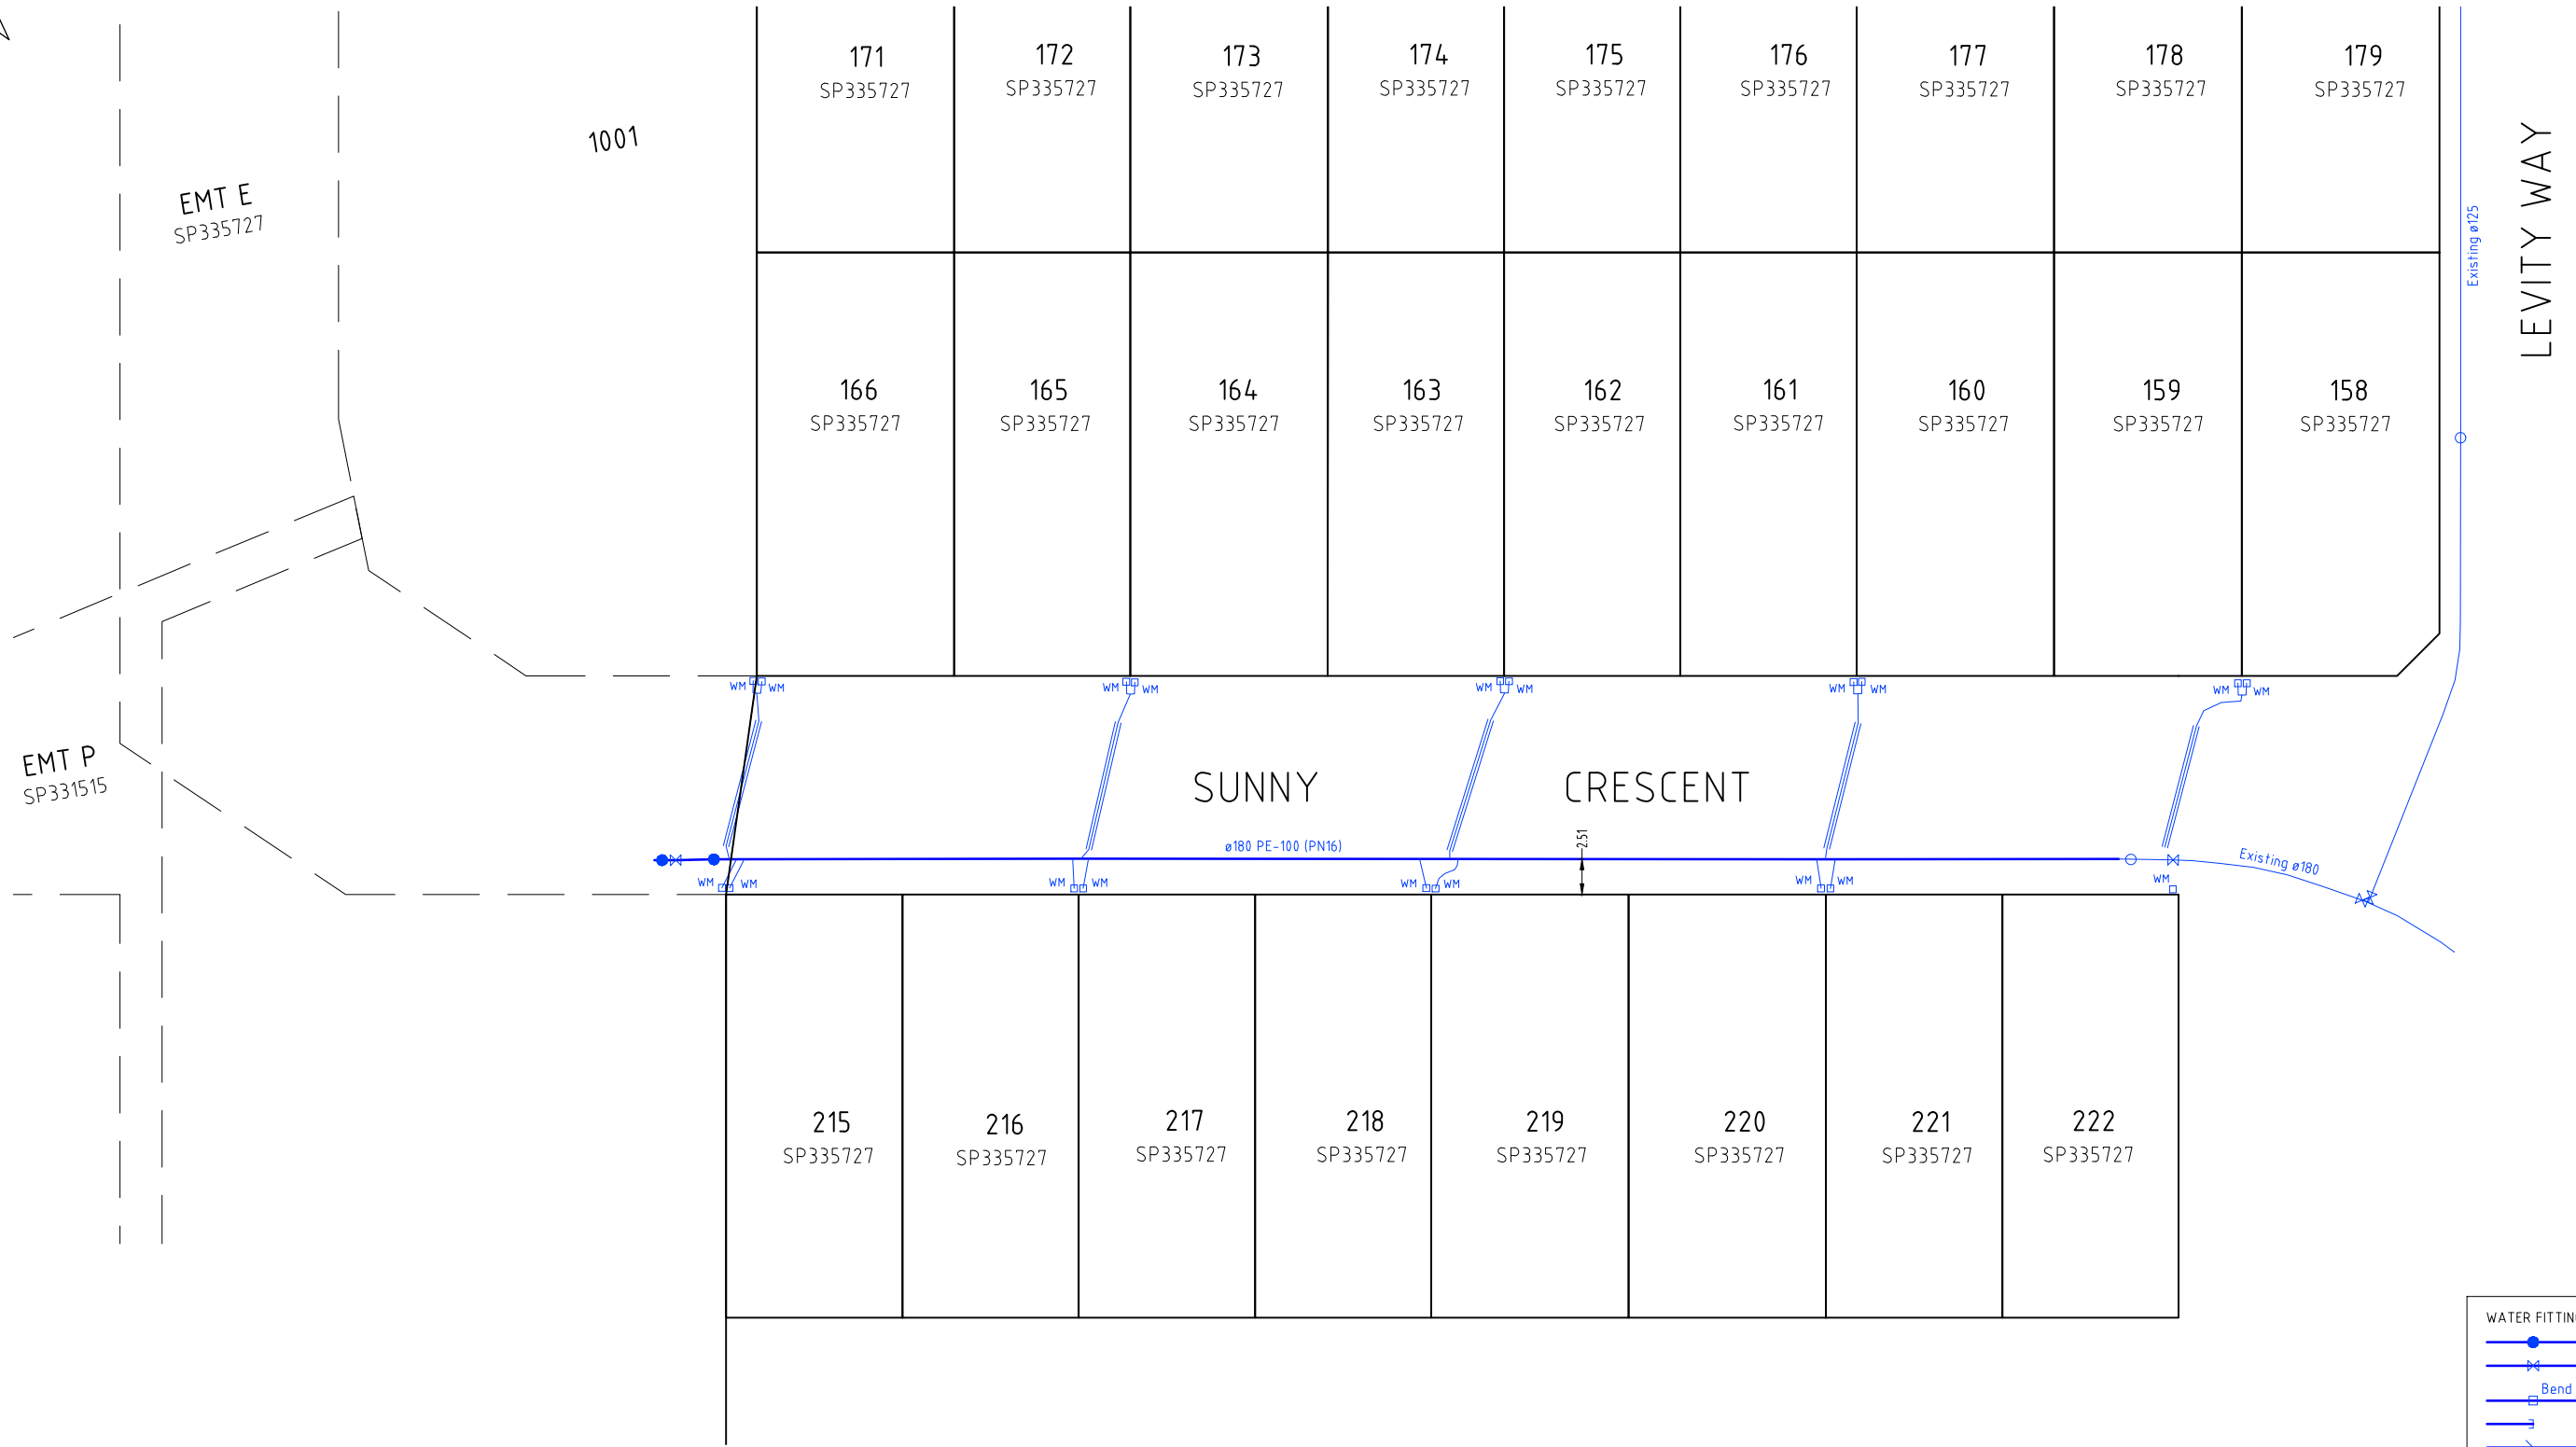

**WATER FITTINGS LEGEND**

	Hydrant
	Valve
	Bend
	Water Fitting
	Dead End Cap
	Reducer
	Water Meter
	Conduit Crossing and Service Pipe

Note: See ADAC xml file for full attribute information

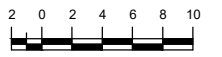

SCALE OF METRES  
1 : 250 FULL SIZE A1 SHEET

A1

REV NO	DATE	REVISION PURPOSE / DESCRIPTION	DRAWN	RPEQ	RPEQ No	INITIALS	DATE
A	25.07.2023	Builders Issue					

DRAWN	CM	20.07.2023
CHECKED	CU	21.07.2023
APPROVED		

**SH saunders havill group**  
 Saunders Havill Group Pty Ltd ABN 54 144 572 540  
 head office 9 Thompson St Bowen Hills Q 4006  
 phone: 0900 423 5142 web: www.saundershavill.com  
 ■ surveying ■ town planning ■ urban design ■ environmental management ■ landscape architecture



BELLEVUE ESTATE - STAGE 7  
 357 RIPLEY ROAD  
 PLAN OF ADAC SURVEY DATA  
 WATER RETICULATION 22-PNT-60099

DRAWING STATUS <b>AS CONSTRUCTED</b>	
SHEET 2 OF 2 SHEETS	
DRAWING NO.	REV. A

Drawing No: 9780 S 44 AC A