


**AS CONSTRUCTED**

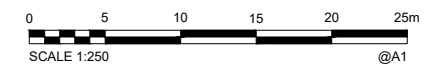

<b>A1</b>	INDEX	DATE	REVISIONS	DRAWN	CHECKED	PASSED
	A	15.09.2023	Builder's Issue			

DRAWN	TG	15.09.2023
CHECKED	CU	15.09.2023
PASSED		
INITIALS	DATE	


**SH saunders havill group**  
 Brisbane Springfield  
 head office 9 Thompson St Bowen Hills Q 4006  
 phone 1300 123 SHG web www.saundershavill.com  
 Drawing No: 9780 S 47 AC A

**Colliers INTERNATIONAL**

**City of Ipswich**

**IPSWICH CITY COUNCIL**  
 AS CONSTRUCTED - ROADS & DRAINAGE  
 BELLEVUE ESTATE - STAGE 8  
 357 RIPLEY ROAD, RIPLEY

SCALE	1:250
SHEET	1 OF 2 SHEETS
DRAWING NO.	

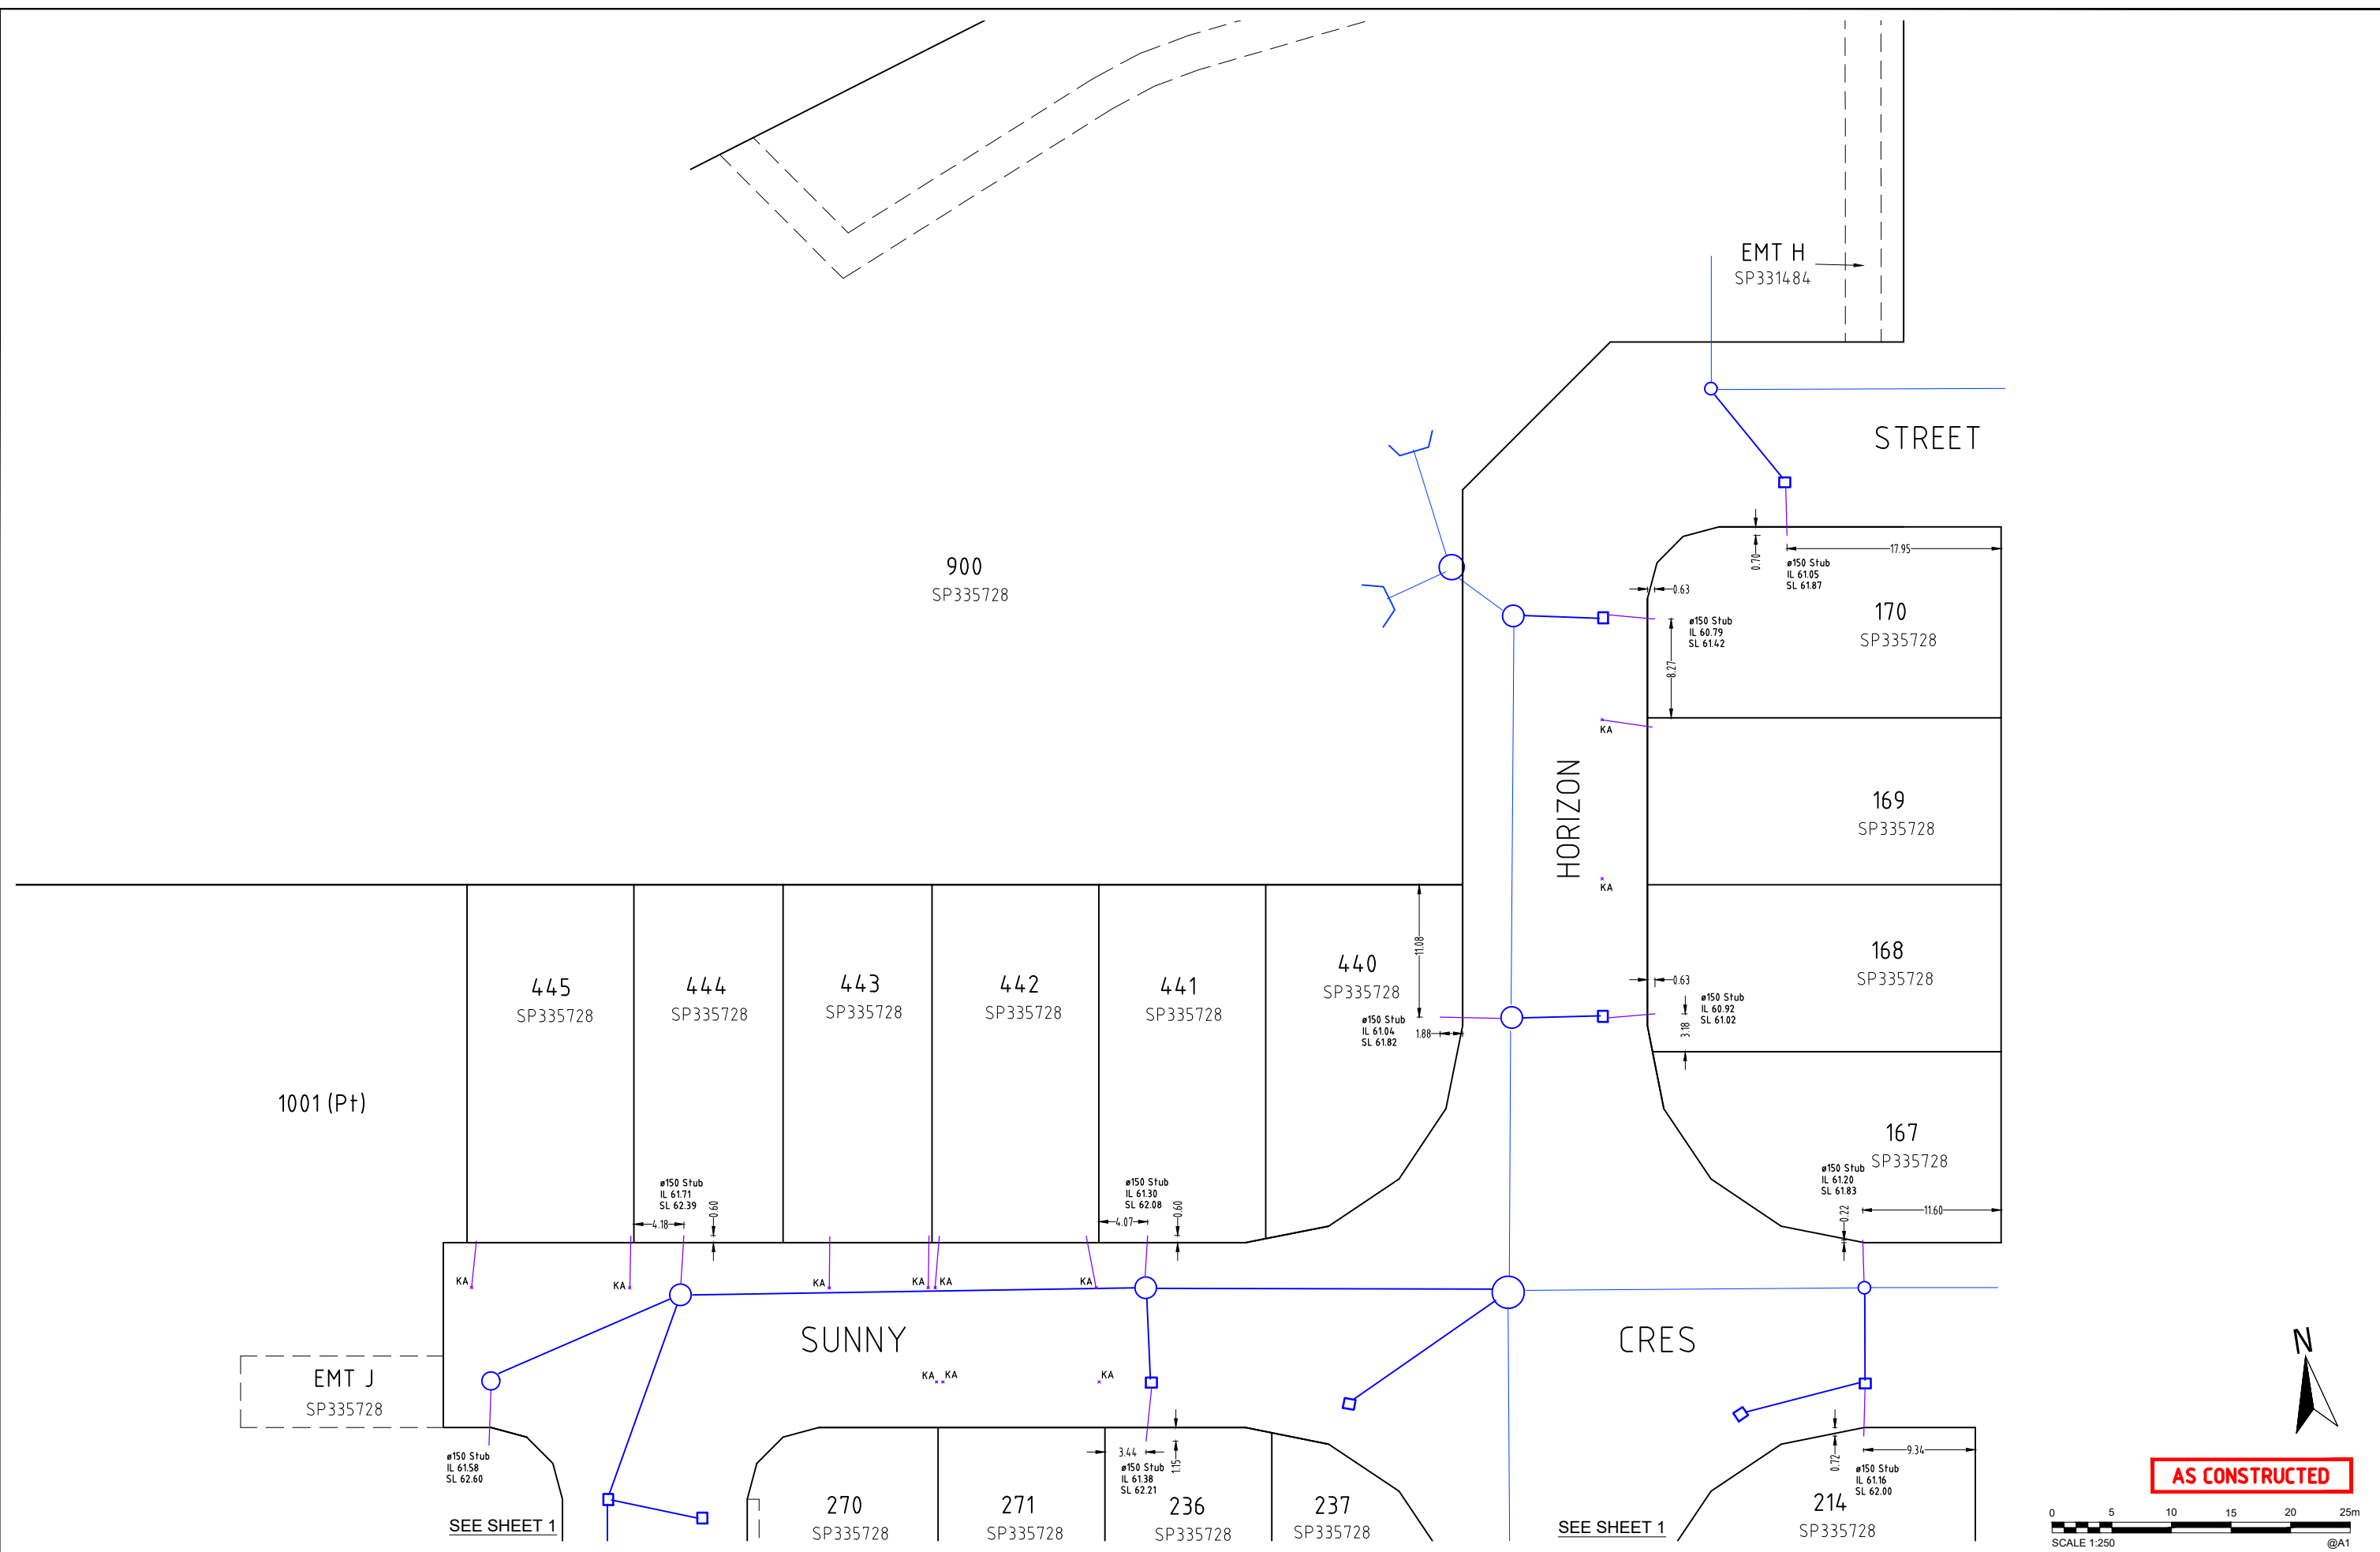

A1	INDEX	DATE	REVISIONS	DRAWN	CHECKED	PASSED
	A	15.09.2023	Builder's Issue			

DRAWN	TG	15.09.2023
CHECKED	CU	15.09.2023
PASSED		
INITIALS	DATE	

**SH saunders havill group**  
 Brisbane Springfield  
 head office 9 Thompson St Bowen Hills Q 4006  
 phone 1300 423 SHG web www.saundershavill.com  
 Drawing No: 9780 S 47 AC A

**Colliers INTERNATIONAL**

**City of Ipswich**

**IPSWICH CITY COUNCIL**  
 AS CONSTRUCTED - ROADS & DRAINAGE  
 BELLEVUE ESTATE - STAGE 8  
 357 RIPLEY ROAD, RIPLEY

SCALE	1:250
SHEET	2 OF 2 SHEETS
DRAWING NO.	