

All house connections are $\phi 110$ unless otherwise noted.

2 0 2 4 6 8 10
SCALE OF METRES
1 : 250 FULL SIZE A1 SHEET

A1											
REV NO	DATE	REVISION PURPOSE / DESCRIPTION	DRAWN	RPEQ	RPEQ No	INITIALS	DATE				
A	15.09.2023	Builders Issue									

	DRAWN	TG	15.09.2023
	CHECKED	CU	15.09.2023
	APPROVED		
	Drawing No: 9780 S 48 AC A		

Saunders Havill Group Pty Ltd ABN 24 144 992 949
 head office 9 Thompson St Bowen Hills Q 4006
 phone 0800 823 SHG web www.saundershavill.com
 ■ surveying ■ town planning ■ urban design ■ environmental management ■ landscape architects

BELLEVUE ESTATE - STAGE 8
SUNNY CRESCENT, RIPLEY

PLAN OF ADAC SURVEY DATA
SEWERAGE RETICULATION 22-PNT-60783

DRAWING STATUS AS CONSTRUCTED	
SHEET 1 OF 2 SHEETS	
DRAWING NO. 9780 S 48 AC A	REV. A



A1									

DRAWN	TG	15.09.2023
CHECKED	CU	15.09.2023
APPROVED		


saunders havill group
 Saunders Havill Group Pty Ltd ABN 24 144 572 540
 head office 5 Thompson St Bowen Hills Q 4006
 phone 0800 833 516 web www.saundershavill.com
 ■ surveying ■ town planning ■ urban design ■ environmental management ■ landscape architecture

Drawing No: 9780 S 48 AC A



BELLEVUE ESTATE - STAGE 8
SUNNY CRESCENT, RIPLEY
PLAN OF ADAC SURVEY DATA
SEWERAGE RETICULATION 22-PNT-60783

DRAWING STATUS AS CONSTRUCTED	
SHEET 2 OF 2 SHEETS	
DRAWING NO. 9780 S 48 AC A	REV. A

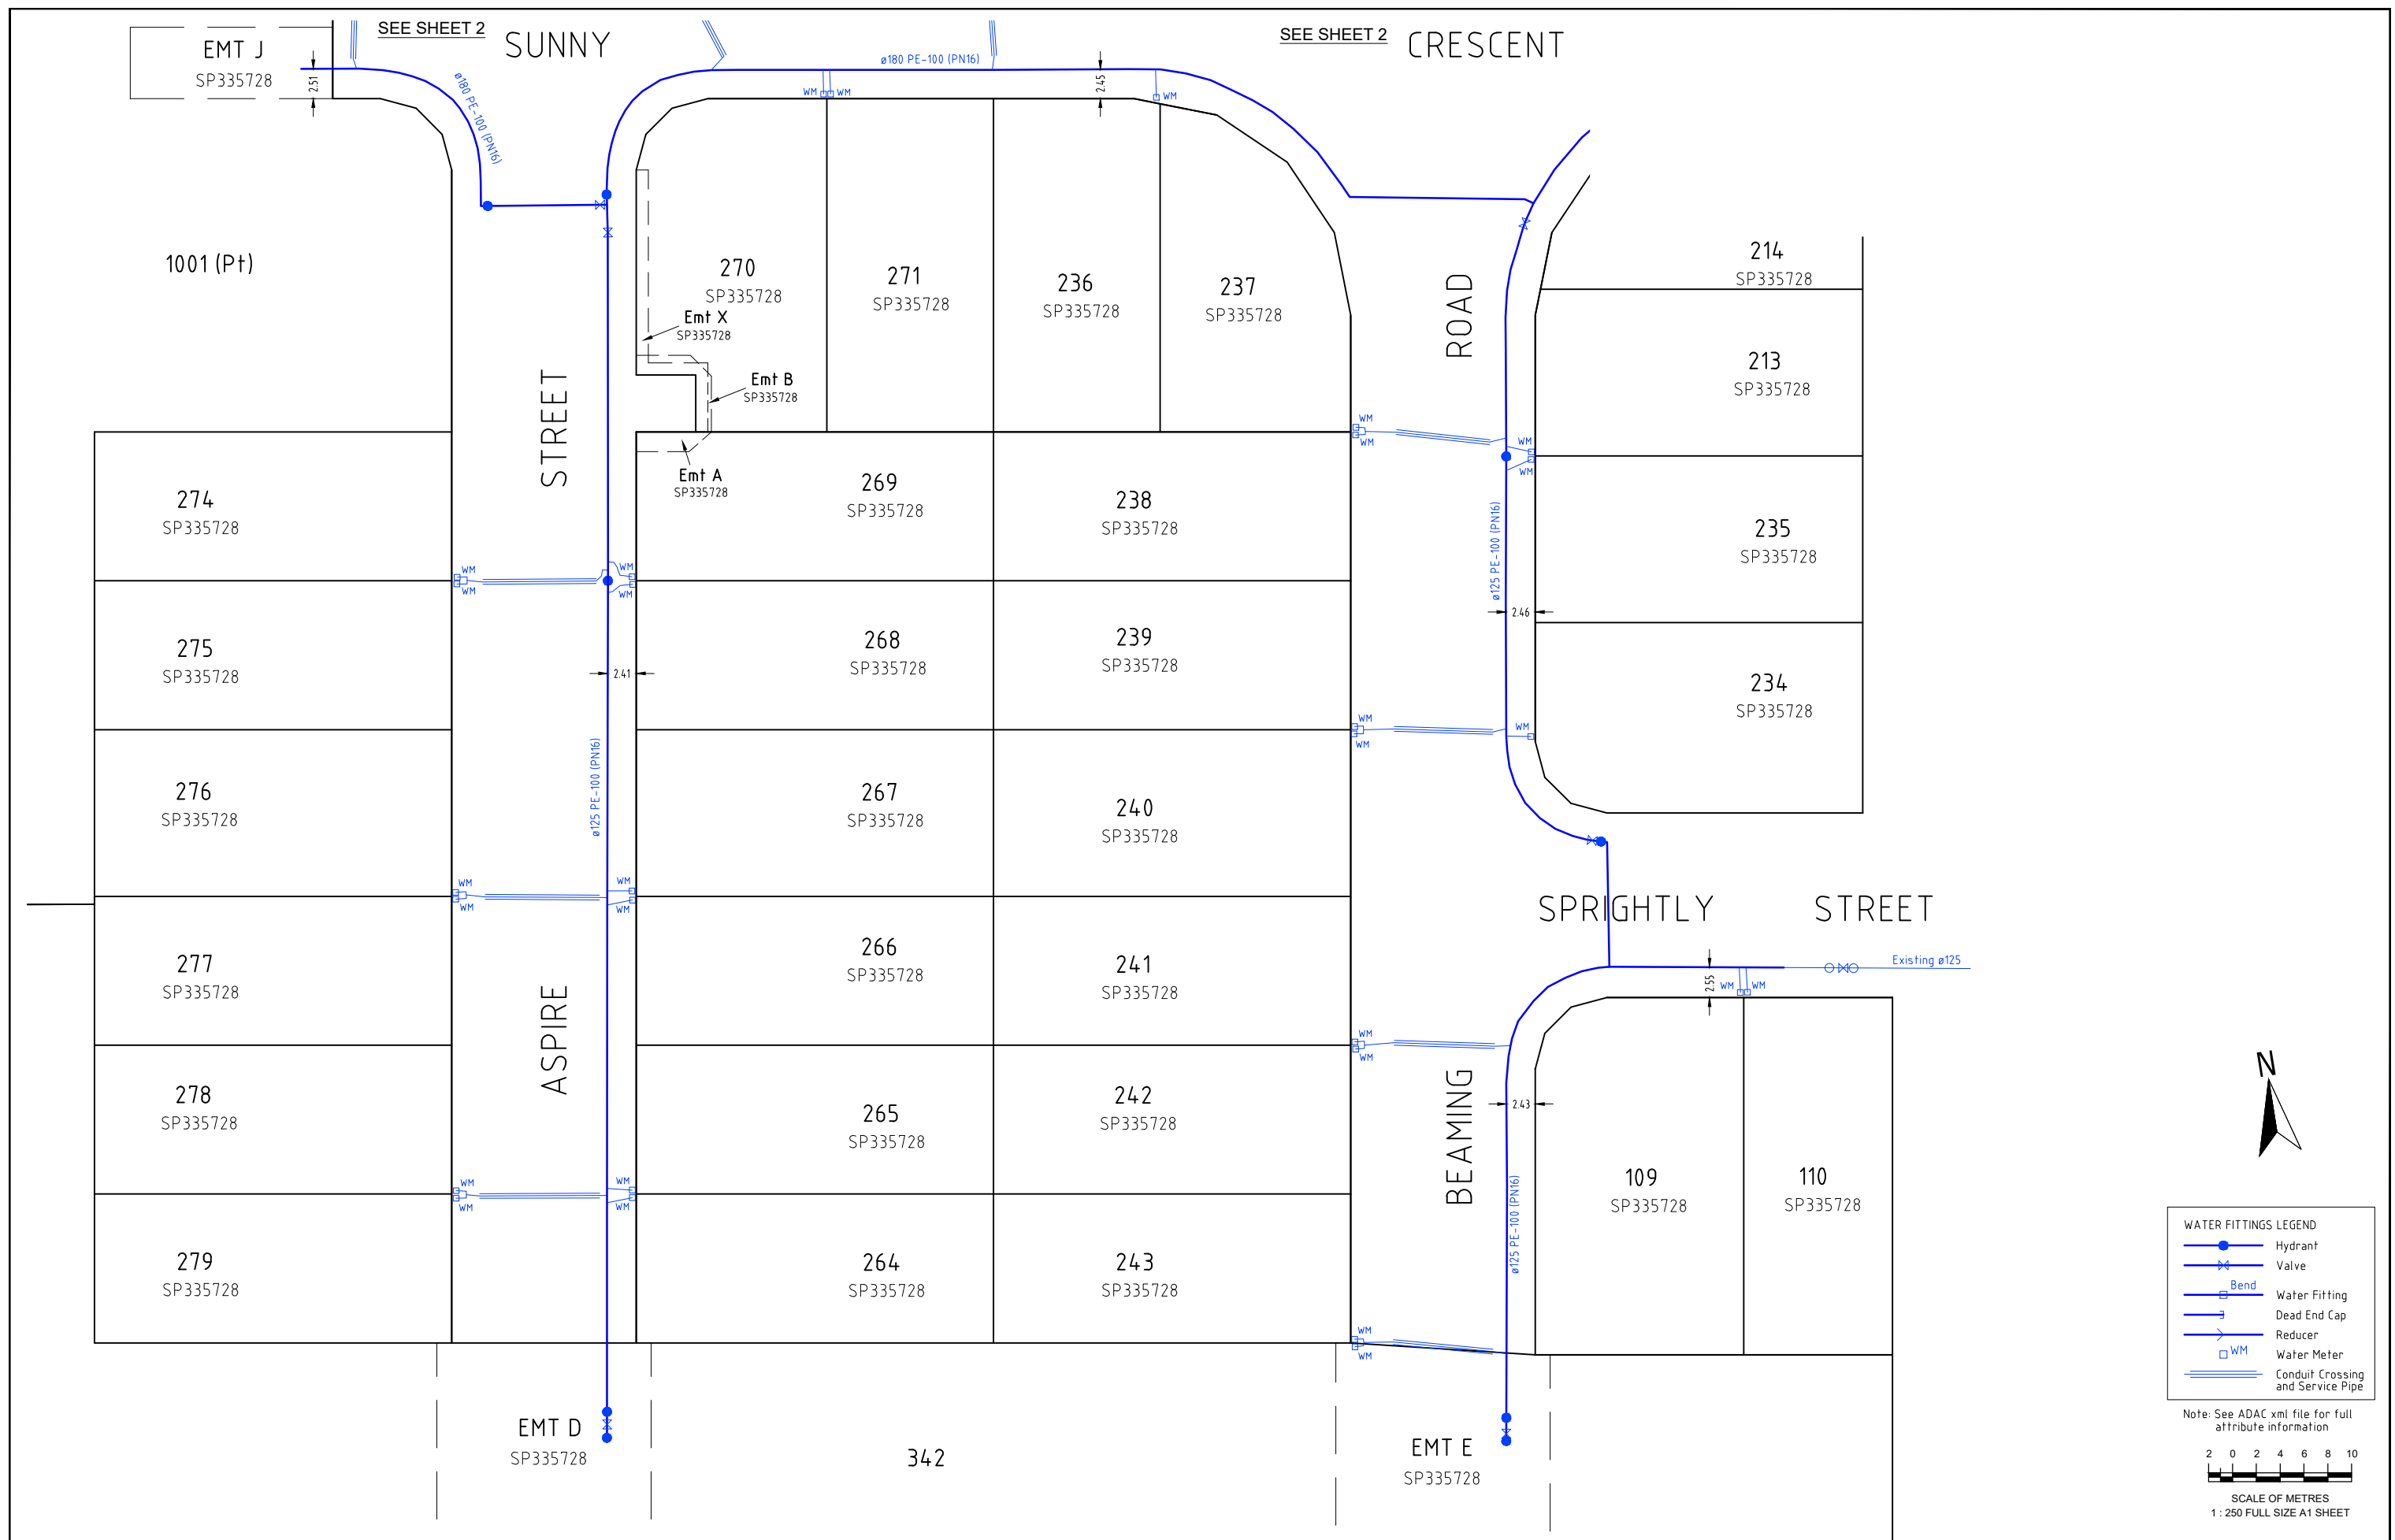

WATER FITTINGS LEGEND

	Hydrant
	Valve
	Water Fitting
	Dead End Cap
	Reducer
	Water Meter
	Conduit Crossing and Service Pipe

Note: See ADAC xml file for full attribute information

2 0 2 4 6 8 10

SCALE OF METRES
1 : 250 FULL SIZE A1 SHEET

A1									
REV NO	DATE	REVISION PURPOSE / DESCRIPTION	DRAWN	RPEQ	RPEQ No	INITIALS	DATE		
A	15.09.2023	Builders Issue							

DRAWN	TG	15.09.2023
CHECKED	CU	15.09.2023
APPROVED		

saunders havill group

Small text: Saunders Havill Group Pty Ltd ABN 24 144 572 540
Head office 9 Thompson St Bowen Hills Q 4006
Phone: 0900 833 5162 web: www.saundershavill.com

UrbanUtilities logo


Drawing No: 9780 S 48 AC A

UrbanUtilities

BELLEVUE ESTATE - STAGE 8
SUNNY CRESCENT, RIPLEY

PLAN OF ADAC SURVEY DATA
WATER RETICULATION 22-PNT-60783


DRAWING STATUS AS CONSTRUCTED	
SHEET 1 OF 2 SHEETS	
DRAWING NO. 9780 S 48 AC A	REV. A

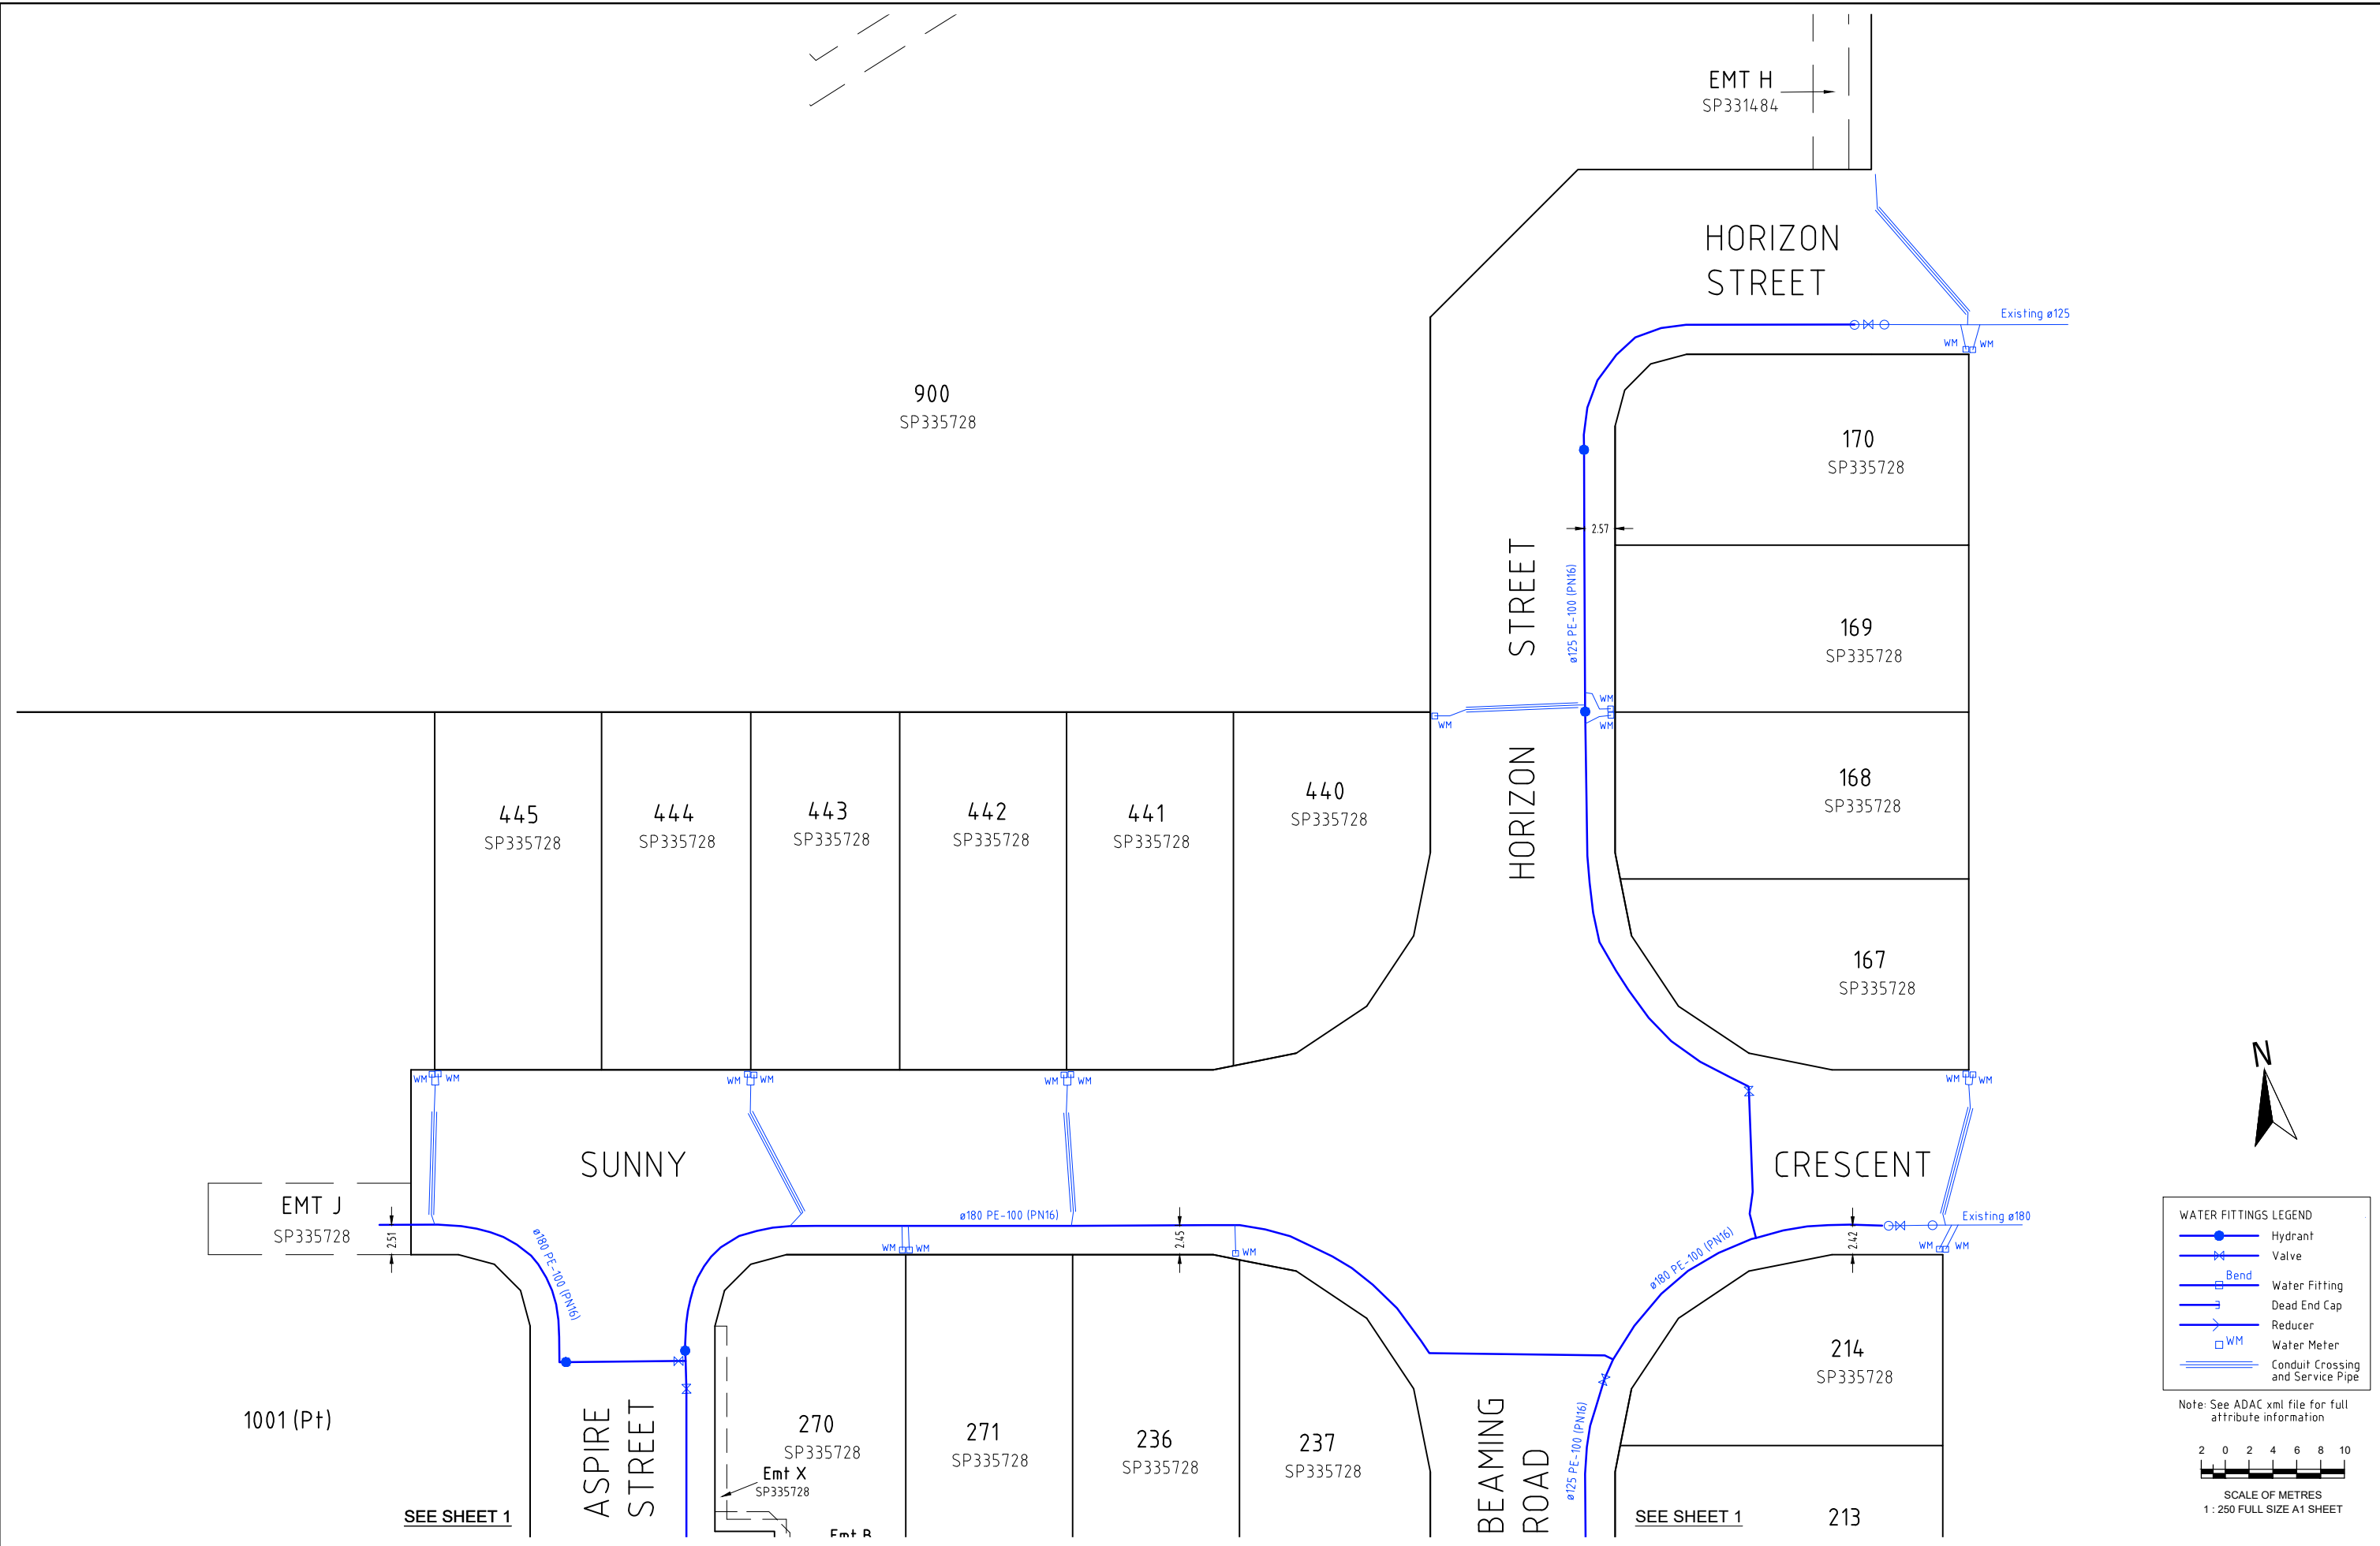

WATER FITTINGS LEGEND

- Hydrant
- Valve
- Bend
- Water Fitting
- Dead End Cap
- Reducer
- Water Meter
- Conduit Crossing and Service Pipe

Note: See ADAC xml file for full attribute information

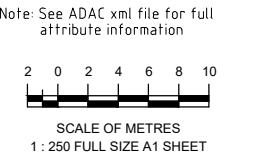

A1

REV NO	DATE	REVISION PURPOSE / DESCRIPTION	DRAWN	RPEQ	RPEQ No
A	15.09.2023	Builders Issue			

DRAWN	TG	15.09.2023
CHECKED	CU	15.09.2023
APPROVED		

saunders havill group

Small text: Saunders Havill Group Pty Ltd ABN 24 144 572 540
 head office 9 Thompson St Bowen Hills Q 4006
 phone: 0800 633 516 web: www.saundershavill.com

Drawing No: 9780 S 48 AC A



BELLEVUE ESTATE - STAGE 8
SUNNY CRESCENT, RIPLEY
 PLAN OF ADAC SURVEY DATA
 WATER RETICULATION 22-PNT-60783

DRAWING STATUS AS CONSTRUCTED	
SHEET 2 OF 2 SHEETS	
DRAWING NO. 9780 S 48 AC A	REV. A