





3420
SP334742

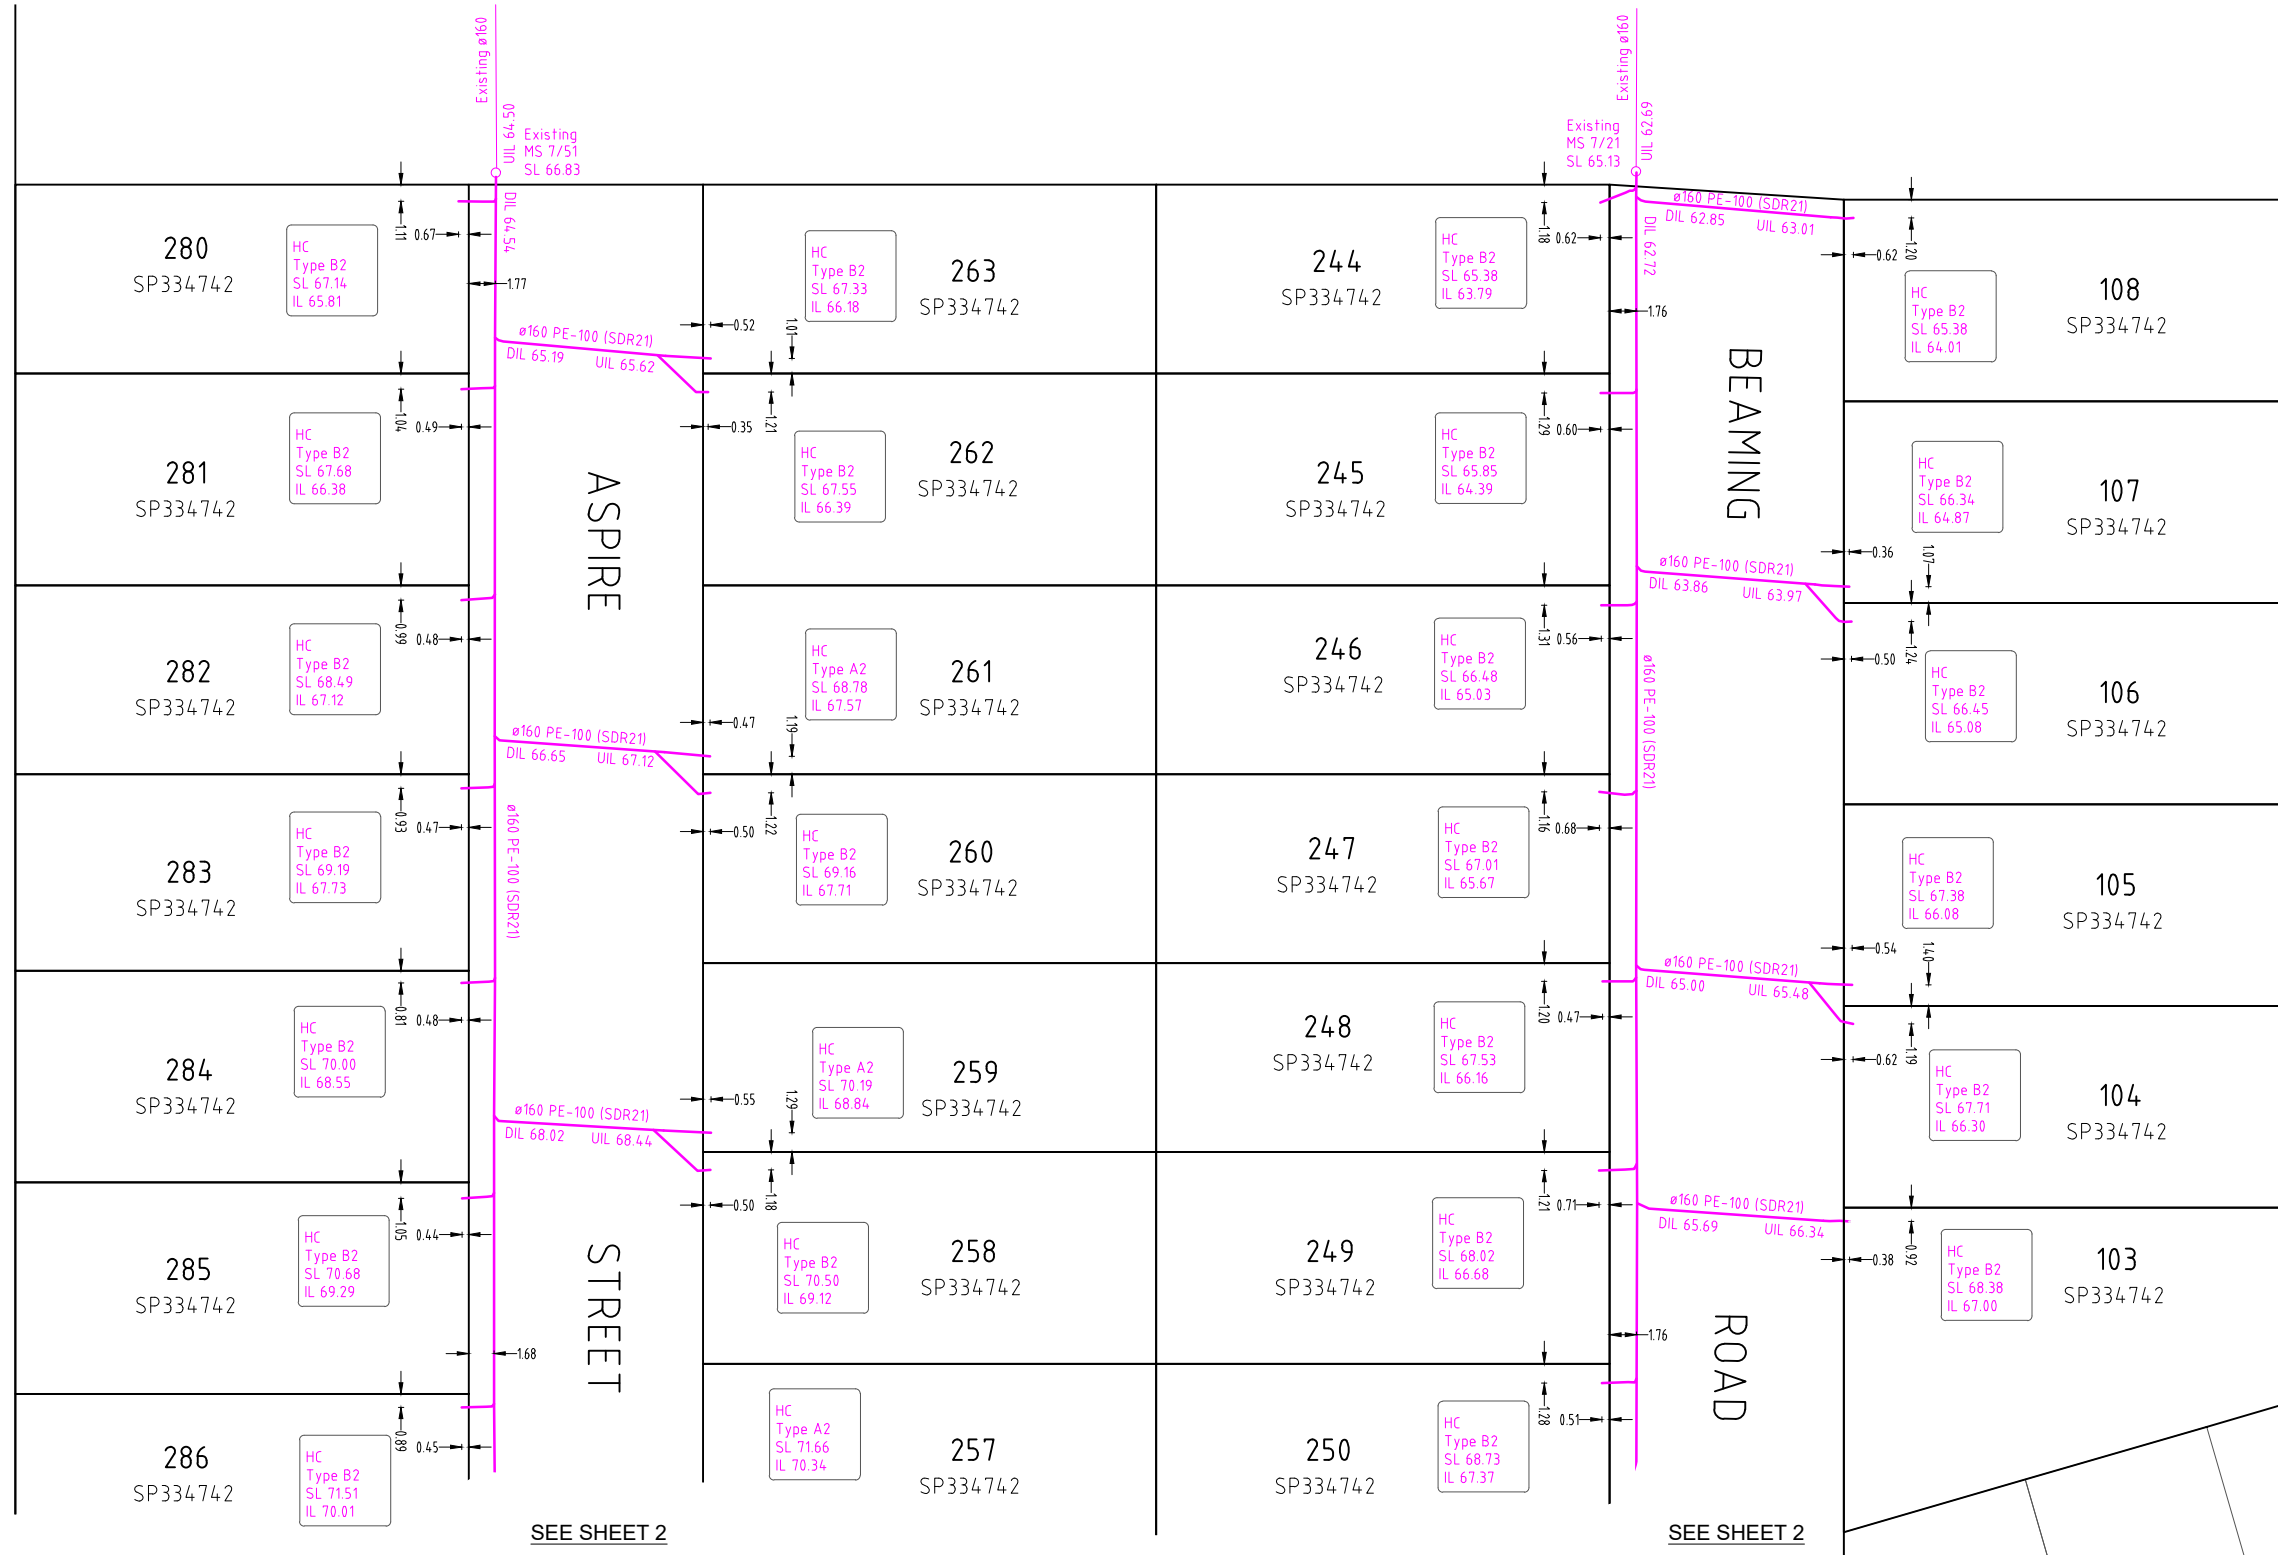

SEE SHEET 2

SEE SHEET 2

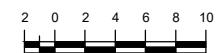

SCALE OF METRES
1 : 250 FULL SIZE A1 SHEET

A1

REV NO	DATE	REVISION PURPOSE / DESCRIPTION	DRAWN	RPEQ	RPEQ No
A	10.11.23	Builders Issue			

DRAWN	CM	08.11.2023
CHECKED	CU	10.11.2023
APPROVED		

saunders havill group
 Saunders Havill Group Pty Ltd ABN 24 144 572 540
 head office 9 Thompson St Bowen Hills Q 4006
 phone: 0900 633 516 web: www.saundershavill.com
 ■ surveying ■ town planning ■ urban design ■ environmental management ■ landscape architecture

Drawing No: 9780 S 51 AC A




BELLEVUE ESTATE - STAGE 9
 RIPLEY
 PLAN OF ADAC SURVEY DATA
 SEWERAGE RETICULATION 22-PNT-60784

DRAWING STATUS	
AS CONSTRUCTED	
SHEET 1 OF 2 SHEETS	
DRAWING NO.	REV.
	A



SEE SHEET 1

SEE SHEET 1

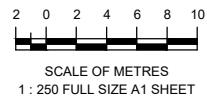

A1	REV NO	DATE	REVISION PURPOSE / DESCRIPTION	DRAWN	RPEQ	RPEQ No	DRAWN	CM	08.11.2023	 <small>Saunders Havill Group Pty Ltd ABN 54 144 572 540 head office 5 Thompson St Bowen Hills Q 4006 phone 090 433 5142 www.saundershavill.com ■ surveying ■ town planning ■ urban design ■ environmental management ■ landscape architecture</small>		BELLEVUE ESTATE - STAGE 9 RIPLEY		DRAWING STATUS AS CONSTRUCTED	
	A	10.11.23	Builders Issue					CU	10.11.2023			PLAN OF ADAC SURVEY DATA SEWERAGE RETICULATION 22-PNT-60784		SHEET 2 OF 2 SHEETS	
													DRAWING NO.		REV. A