


WATER FITTINGS LEGEND	
	Hydrant
	Valve
	Bend
	Water Fitting
	Dead End Cap
	Reducer
	Water Meter
	Conduit Crossing and Service Pipe

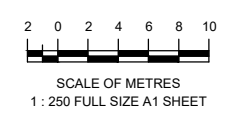

A1

REV NO	DATE	REVISION PURPOSE / DESCRIPTION	DRAWN	RPEQ	RPEQ No
A	10.11.23	Builders Issue			

DRAWN	CM	08.11.2023
CHECKED	CU	10.11.2023
APPROVED		


saunders havill group
 Saunders Havill Group Pty Ltd ABN 54 144 572 540
 head office 9 Thompson St Bowen Hills Q 4006
 phone 090 433 5142 web www.saundershavill.com
 ■ surveying ■ town planning ■ urban design ■ environmental management ■ landscape architecture



BELLEVUE ESTATE - STAGE 9
 RIPLEY
 PLAN OF ADAC SURVEY DATA
 WATER RETICULATION 22-PNT-60784

DRAWING STATUS	
AS CONSTRUCTED	
SHEET 1 OF 2 SHEETS	
DRAWING NO.	REV.
	A

Drawing No: 9780 S 51 AC A

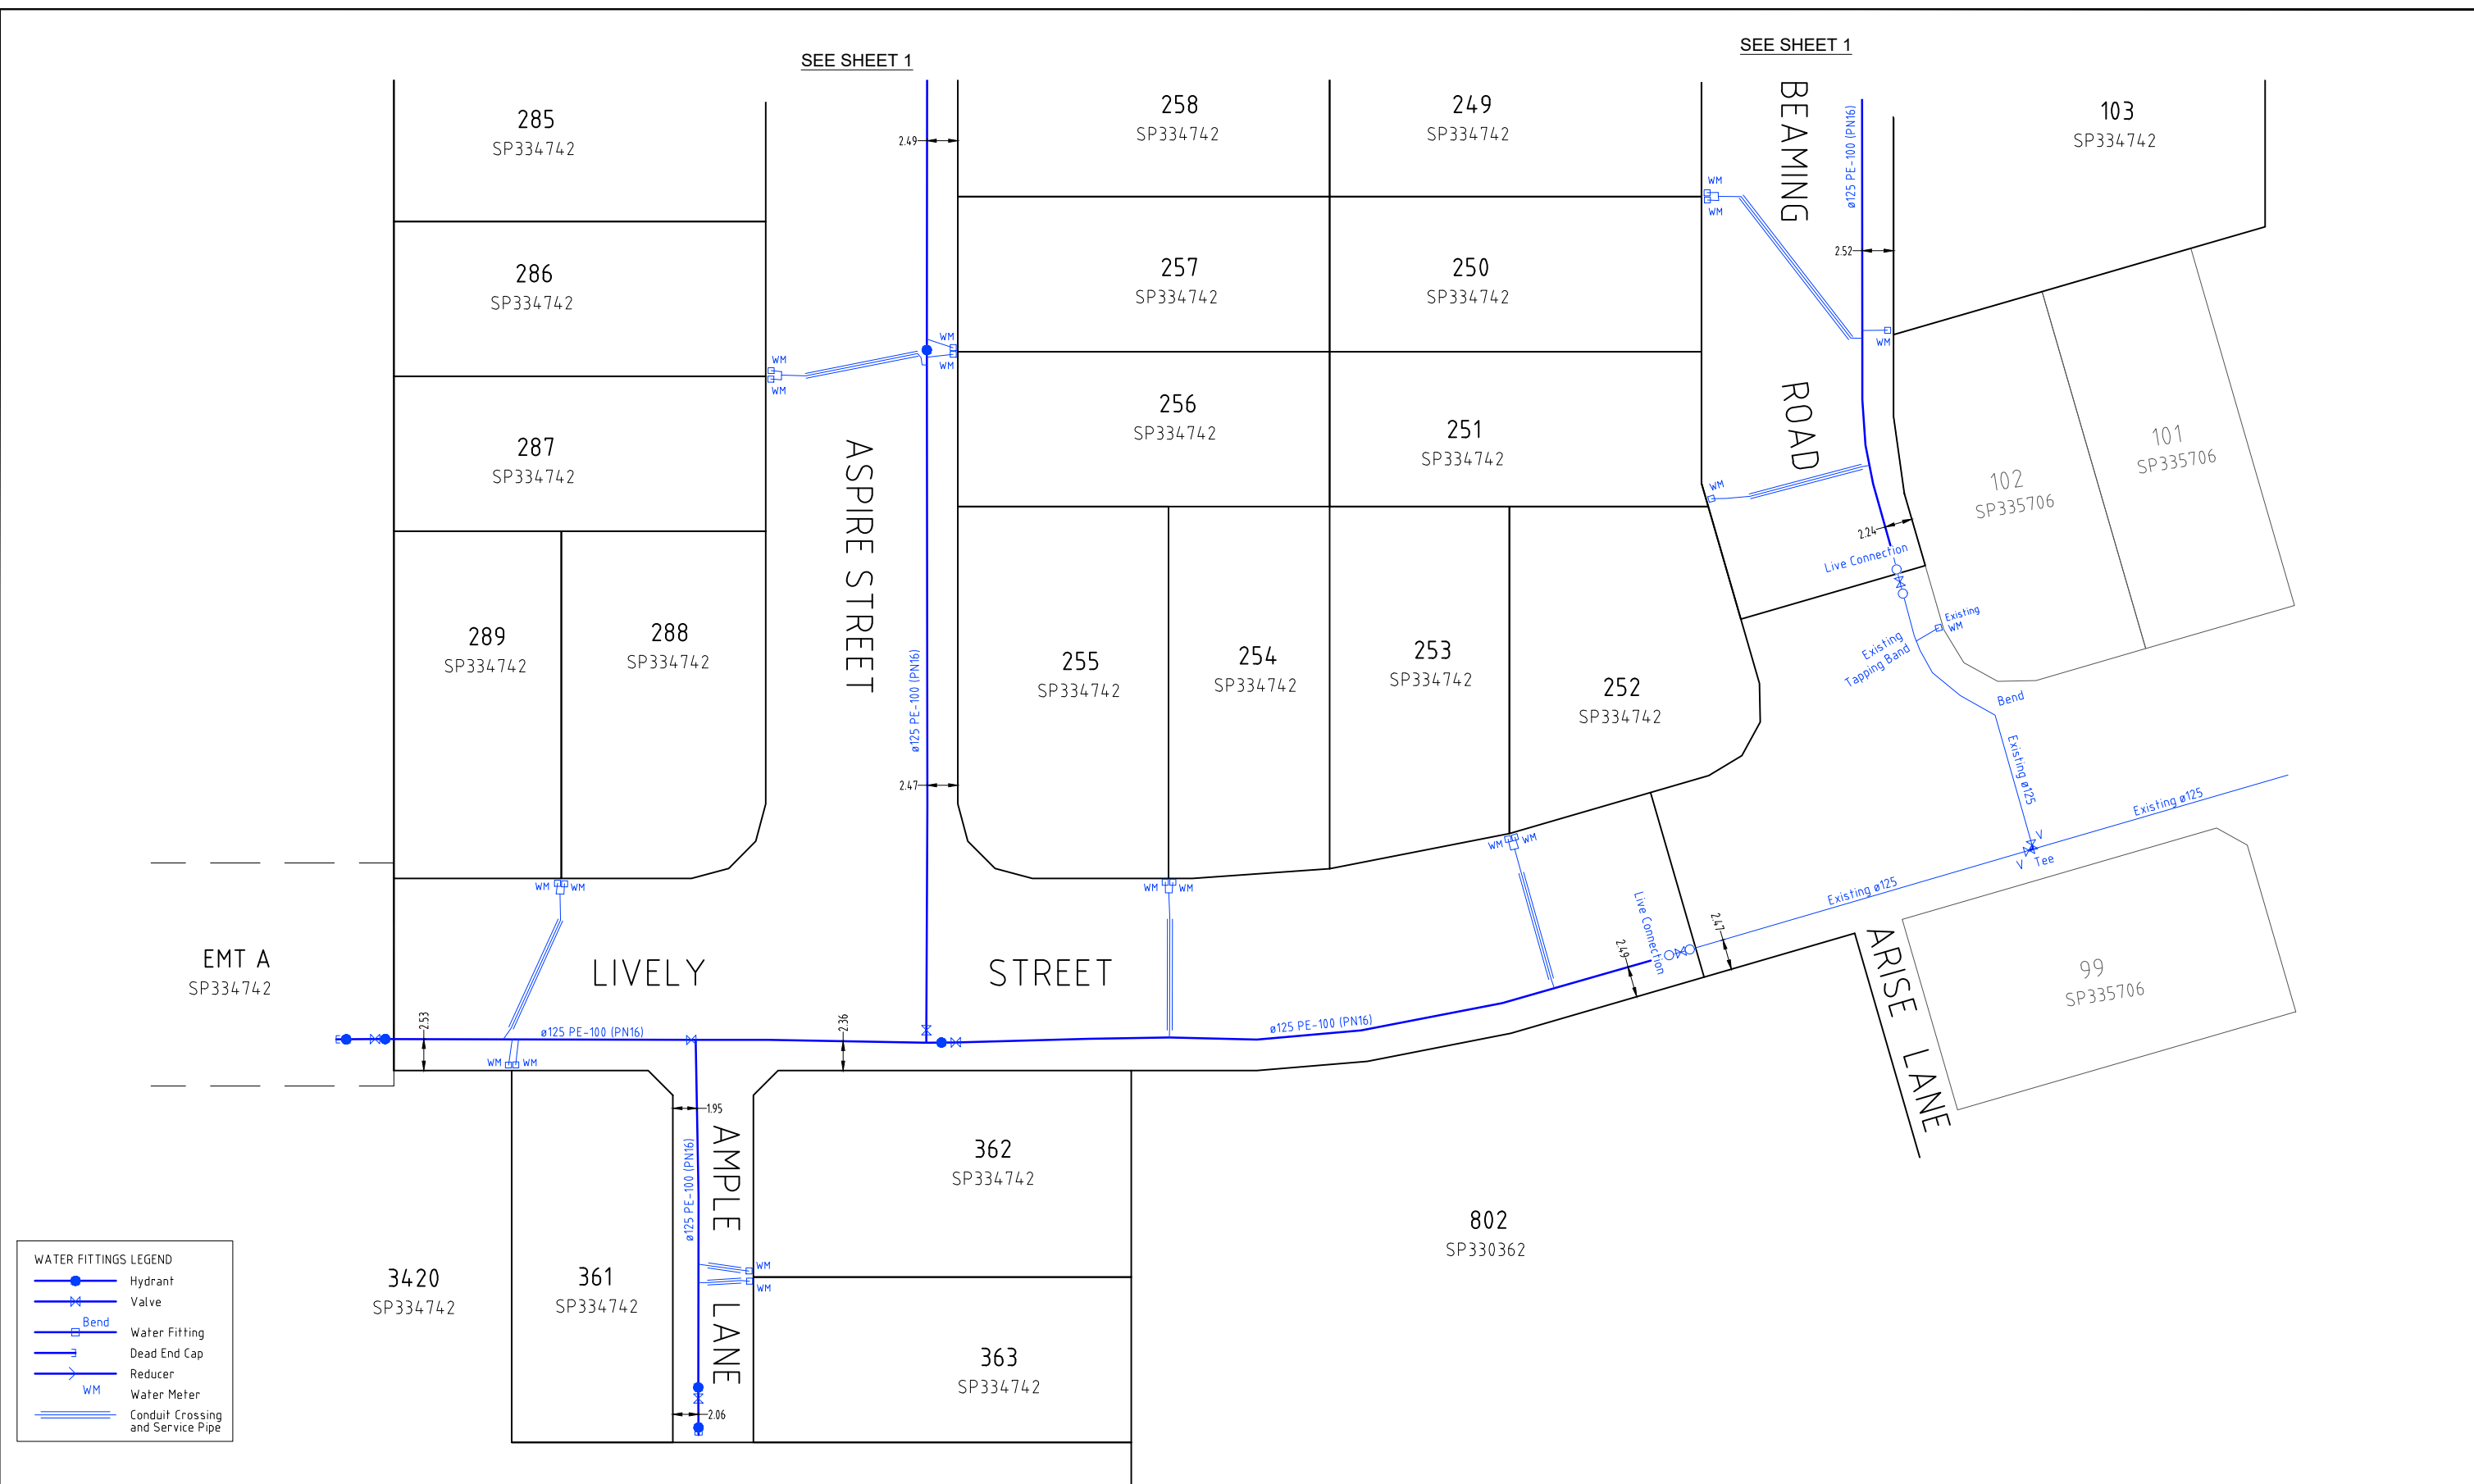

A1

REV NO	DATE	REVISION PURPOSE / DESCRIPTION	DRAWN	RPEQ	RPEQ No
A	10.11.23	Builders Issue			

DRAWN	CM	08.11.2023
CHECKED	CU	10.11.2023
APPROVED		
INITIALS		DATE

SH saunders havill group
 Saunders Havill Group Pty Ltd ABN 54 144 592 540
 head office 9 Thompson St Bowen Hills Q 4006
 phone 090 433 5142 web www.saundershavill.com
 ■ surveying ■ town planning ■ urban design ■ environmental management ■ landscape architecture

Drawing No: 9780 S 51 AC A



**BELLEVUE ESTATE - STAGE 9
RIPLEY**

**PLAN OF ADAC SURVEY DATA
WATER RETICULATION 22-PNT-60784**

DRAWING STATUS	
AS CONSTRUCTED	
SHEET 2 OF 2 SHEETS	
DRAWING NO.	REV.
	A