


**AS CONSTRUCTED**



<b>A1</b>	INDEX	DATE	REVISIONS	DRAWN	CHECKED	PASSED
	A	19/07/2024	Builder's Issue			


DRAWN	EM	15.07.2024
CHECKED	CU	11.07.2024
PASSED		
INITIALS	DATE	

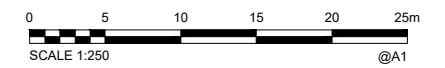


**IPSWICH CITY COUNCIL**

AS CONSTRUCTED - ROADS & DRAINAGE  
BELLEVUE ESTATE - STAGE 10  
SUNNY CRESCENT, RIPLEY

SCALE	1:250
SHEET	1 OF 3 SHEETS
DRAWING NO.	

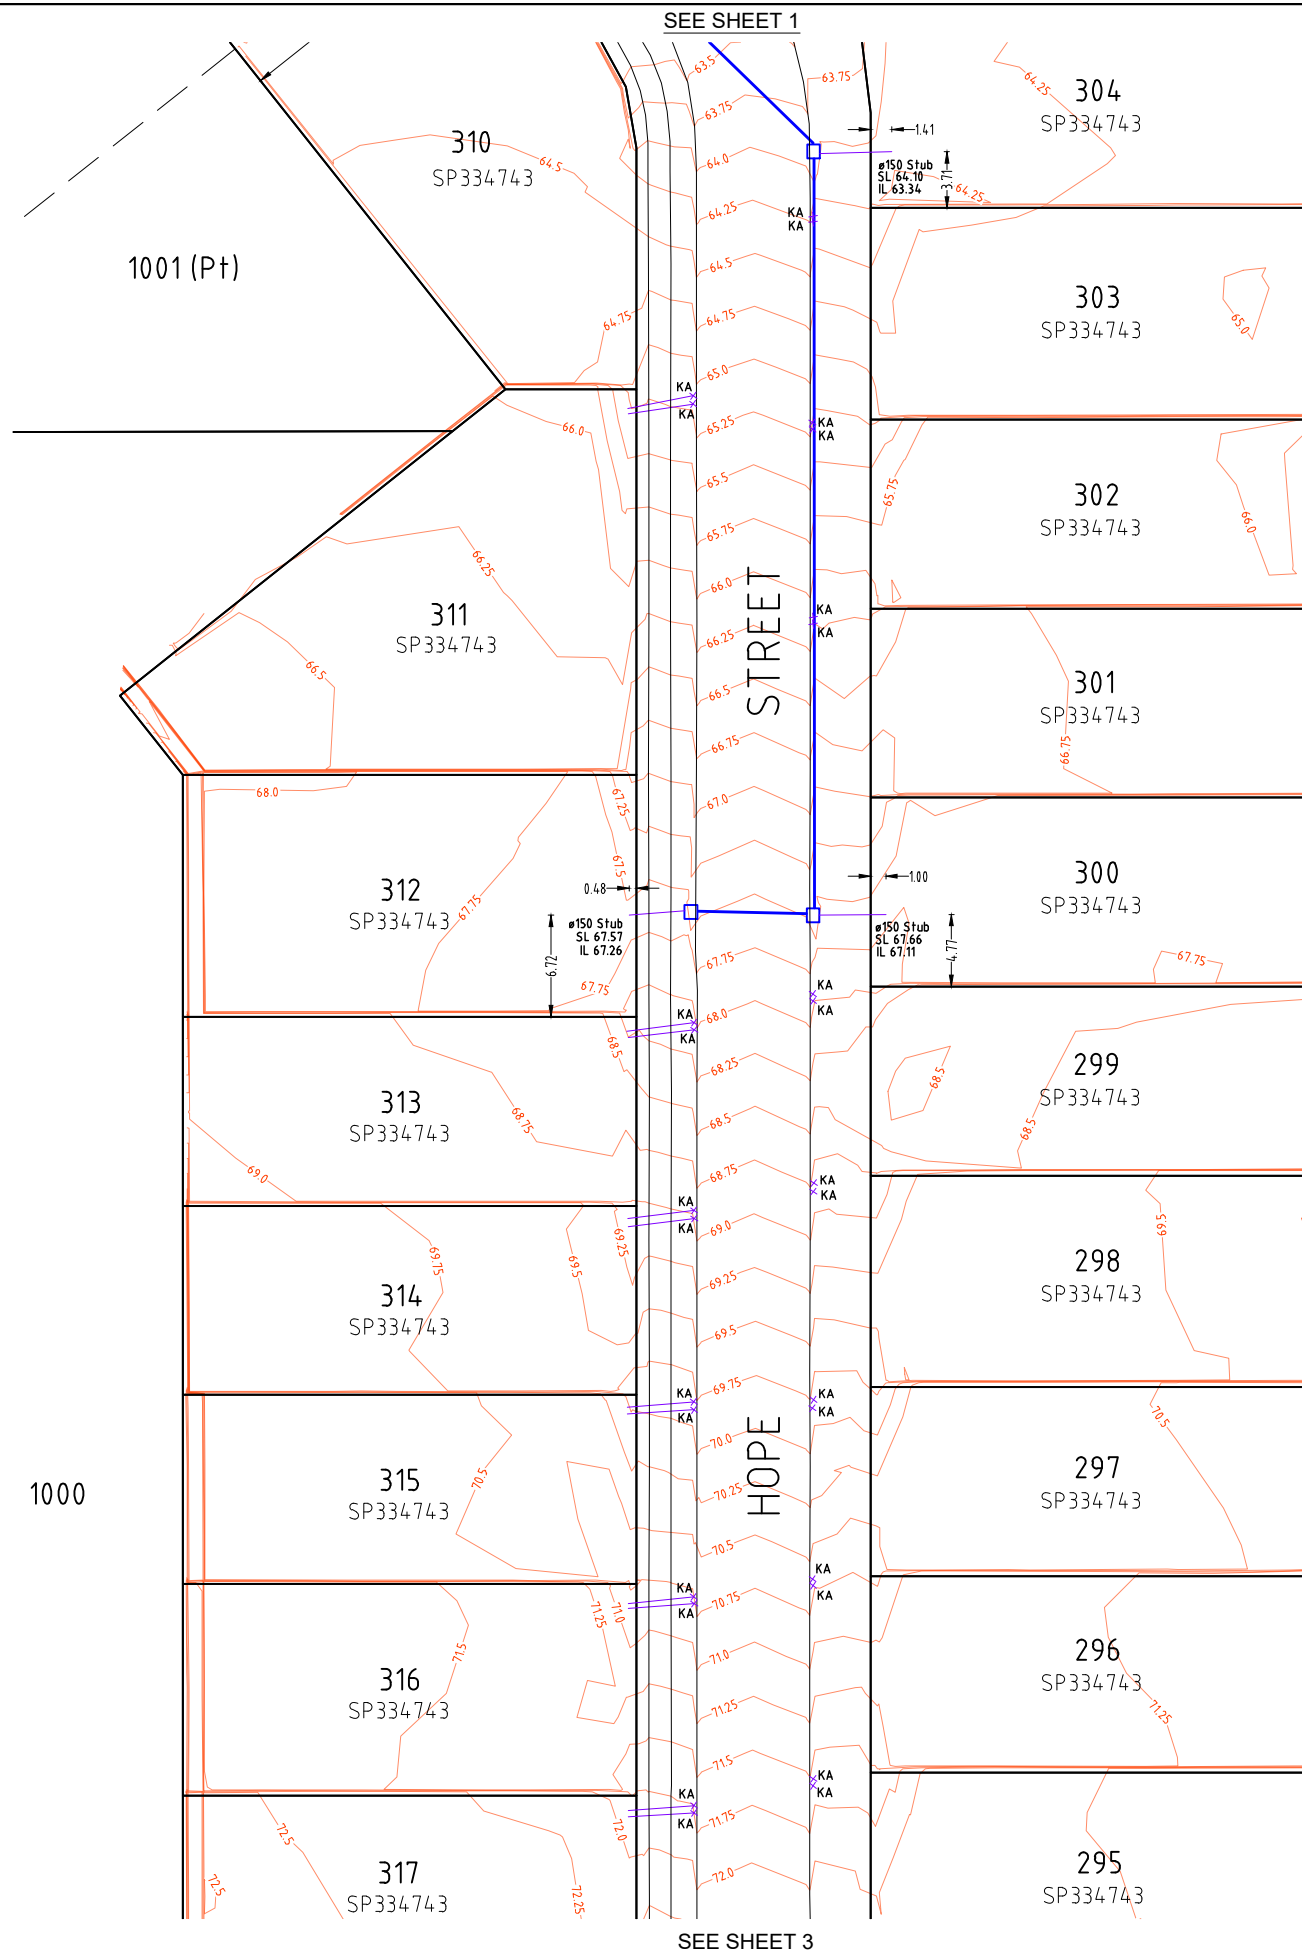

**AS CONSTRUCTED**

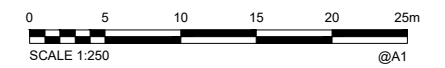

**A1**

INDEX	DATE	REVISIONS	DRAWN	CHECKED	PASSED
A	19/07/2024	Builder's Issue			

INITIALS	DATE
DRAWN CM	15.07.2024
CHECKED CU	11.07.2024
PASSED	

**saunders havill group**  
 Brisbane Springfield  
 head office 9 Thompson St Bowen Hills Q 4006  
 phone 1300 123 SHG web www.saundershavill.com  
 Drawing No: 9780 S 65 AC A

**Colliers INTERNATIONAL**

**City of Ipswich**

**IPSWICH CITY COUNCIL**


AS CONSTRUCTED - ROADS & DRAINAGE  
 BELLEVUE ESTATE - STAGE 10  
 SUNNY CRESCENT, RIPLEY

SCALE	1:250
SHEET	2 OF 3 SHEETS
DRAWING NO.	




SEE SHEET 2

1000

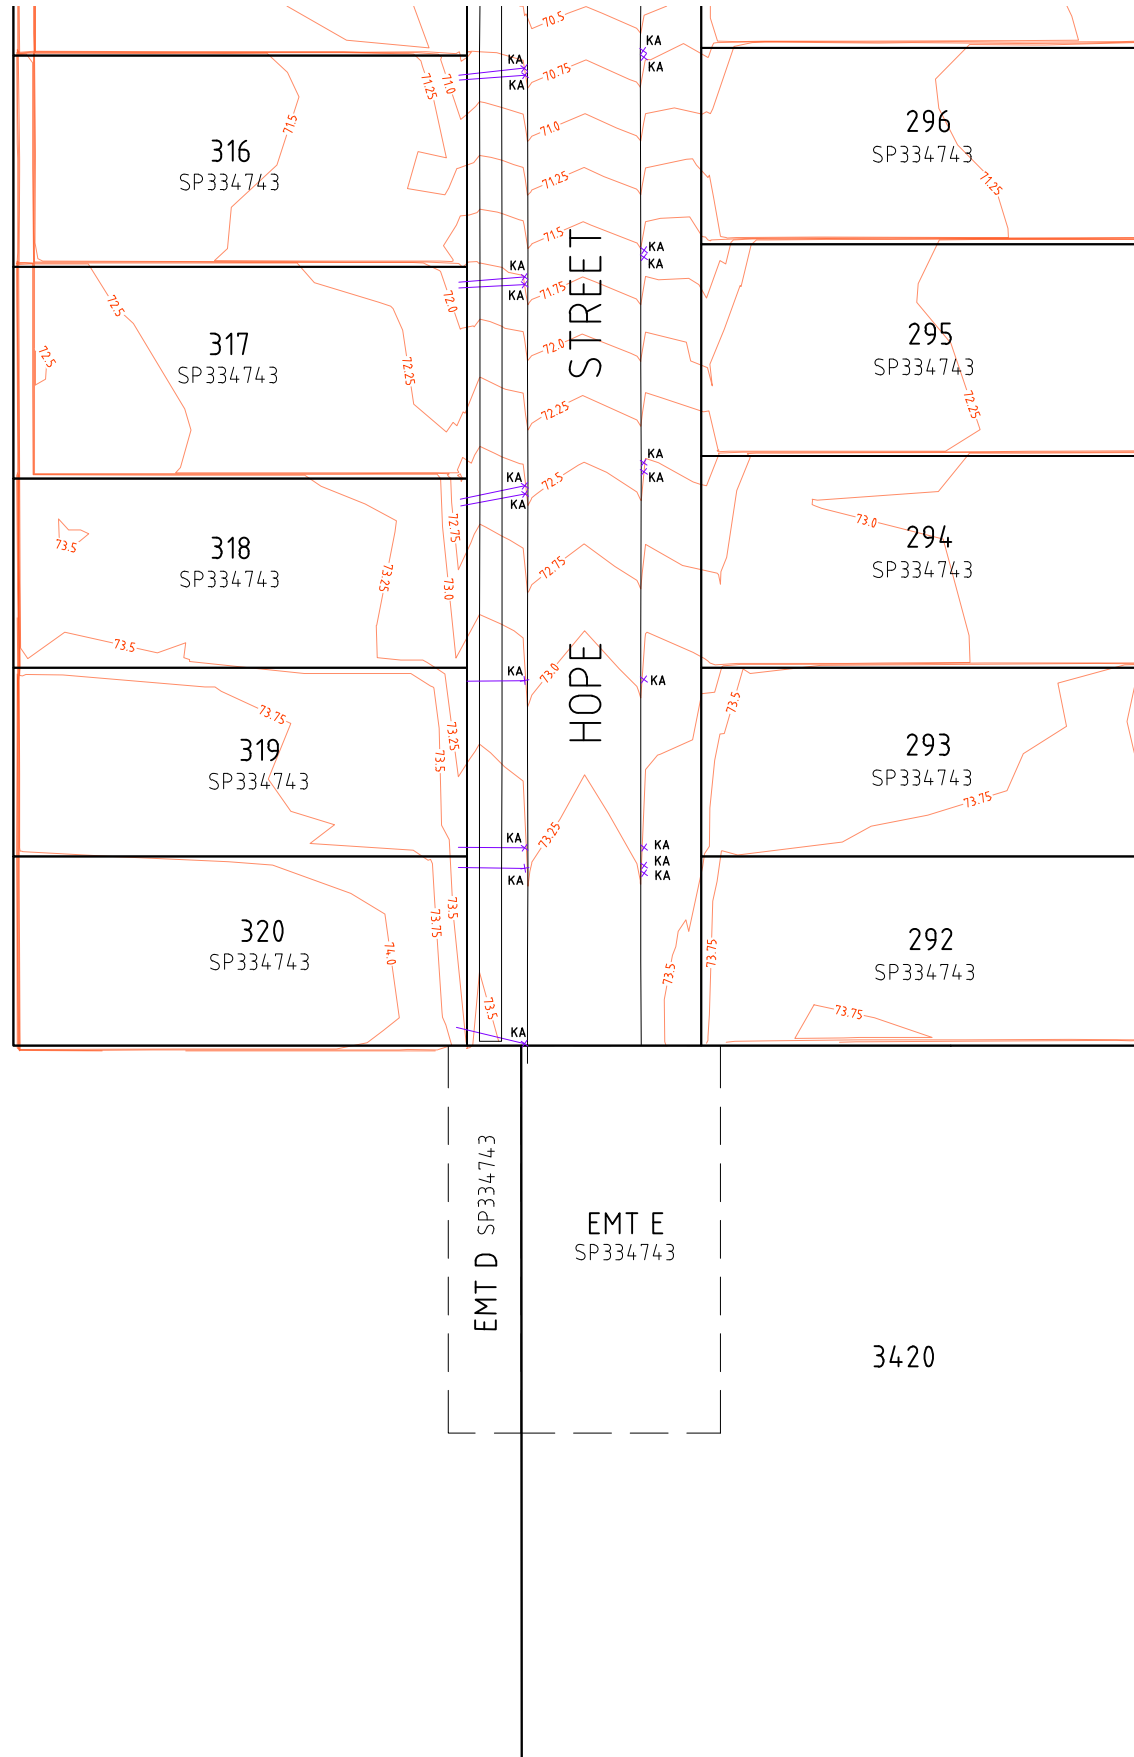

**AS CONSTRUCTED**

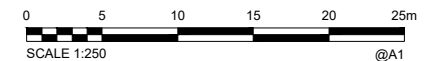

**A1**

INDEX	DATE	REVISIONS	DRAWN	CHECKED	PASSED
A	19/07/2024	Builder's Issue			

DRAWN	CHECKED	PASSED	INITIALS	DATE
EM	CU			15.07.2024
				11.07.2024

**SH saunders havill group**  
 Brisbane Springfield  
 head office 9 Thompson St Bowen Hills Q 4006  
 phone 1300 123 SHG web www.saundershavill.com  
 Drawing No: 9780 S 65 AC A



**IPSWICH CITY COUNCIL**

AS CONSTRUCTED - ROADS & DRAINAGE  
BELLEVUE ESTATE - STAGE 10  
SUNNY CRESCENT, RIPLEY

SCALE	1:250
SHEET	3 OF 3 SHEETS
DRAWING NO.	