


All house connections are Ø110 unless otherwise noted.

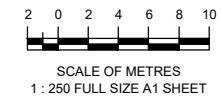

A1									
REV NO	DATE	REVISION PURPOSE / DESCRIPTION	DRAWN	RPEQ	RPEQ No				
A	03/09/2024	Builders Issue							

DRAWN	TG	29/08/2024
CHECKED	MK	02/09/2024
APPROVED		
	INITIALS	DATE


saunders havill group
 Saunders Havill Group Pty Ltd ABN 84 664 979 949
 head office 2 Thompson St Bowen Hills Q 4006
 phone 800 678 546 web www.saundershavill.com
 ■ surveying ■ town planning ■ civil design ■ environmental management ■ landscape architecture

Drawing No: 9780 S 66 AC A




BELLEVUE ESTATE - STAGE 11
SUNNY CRESCENT, RIPLEY
PLAN OF ADAC SURVEY DATA
SEWERAGE RETICULATION 23-PNT-65217

DRAWING STATUS	
AS CONSTRUCTED	
SHEET 1 OF 2 SHEETS	
DRAWING NO.	REV.
	A

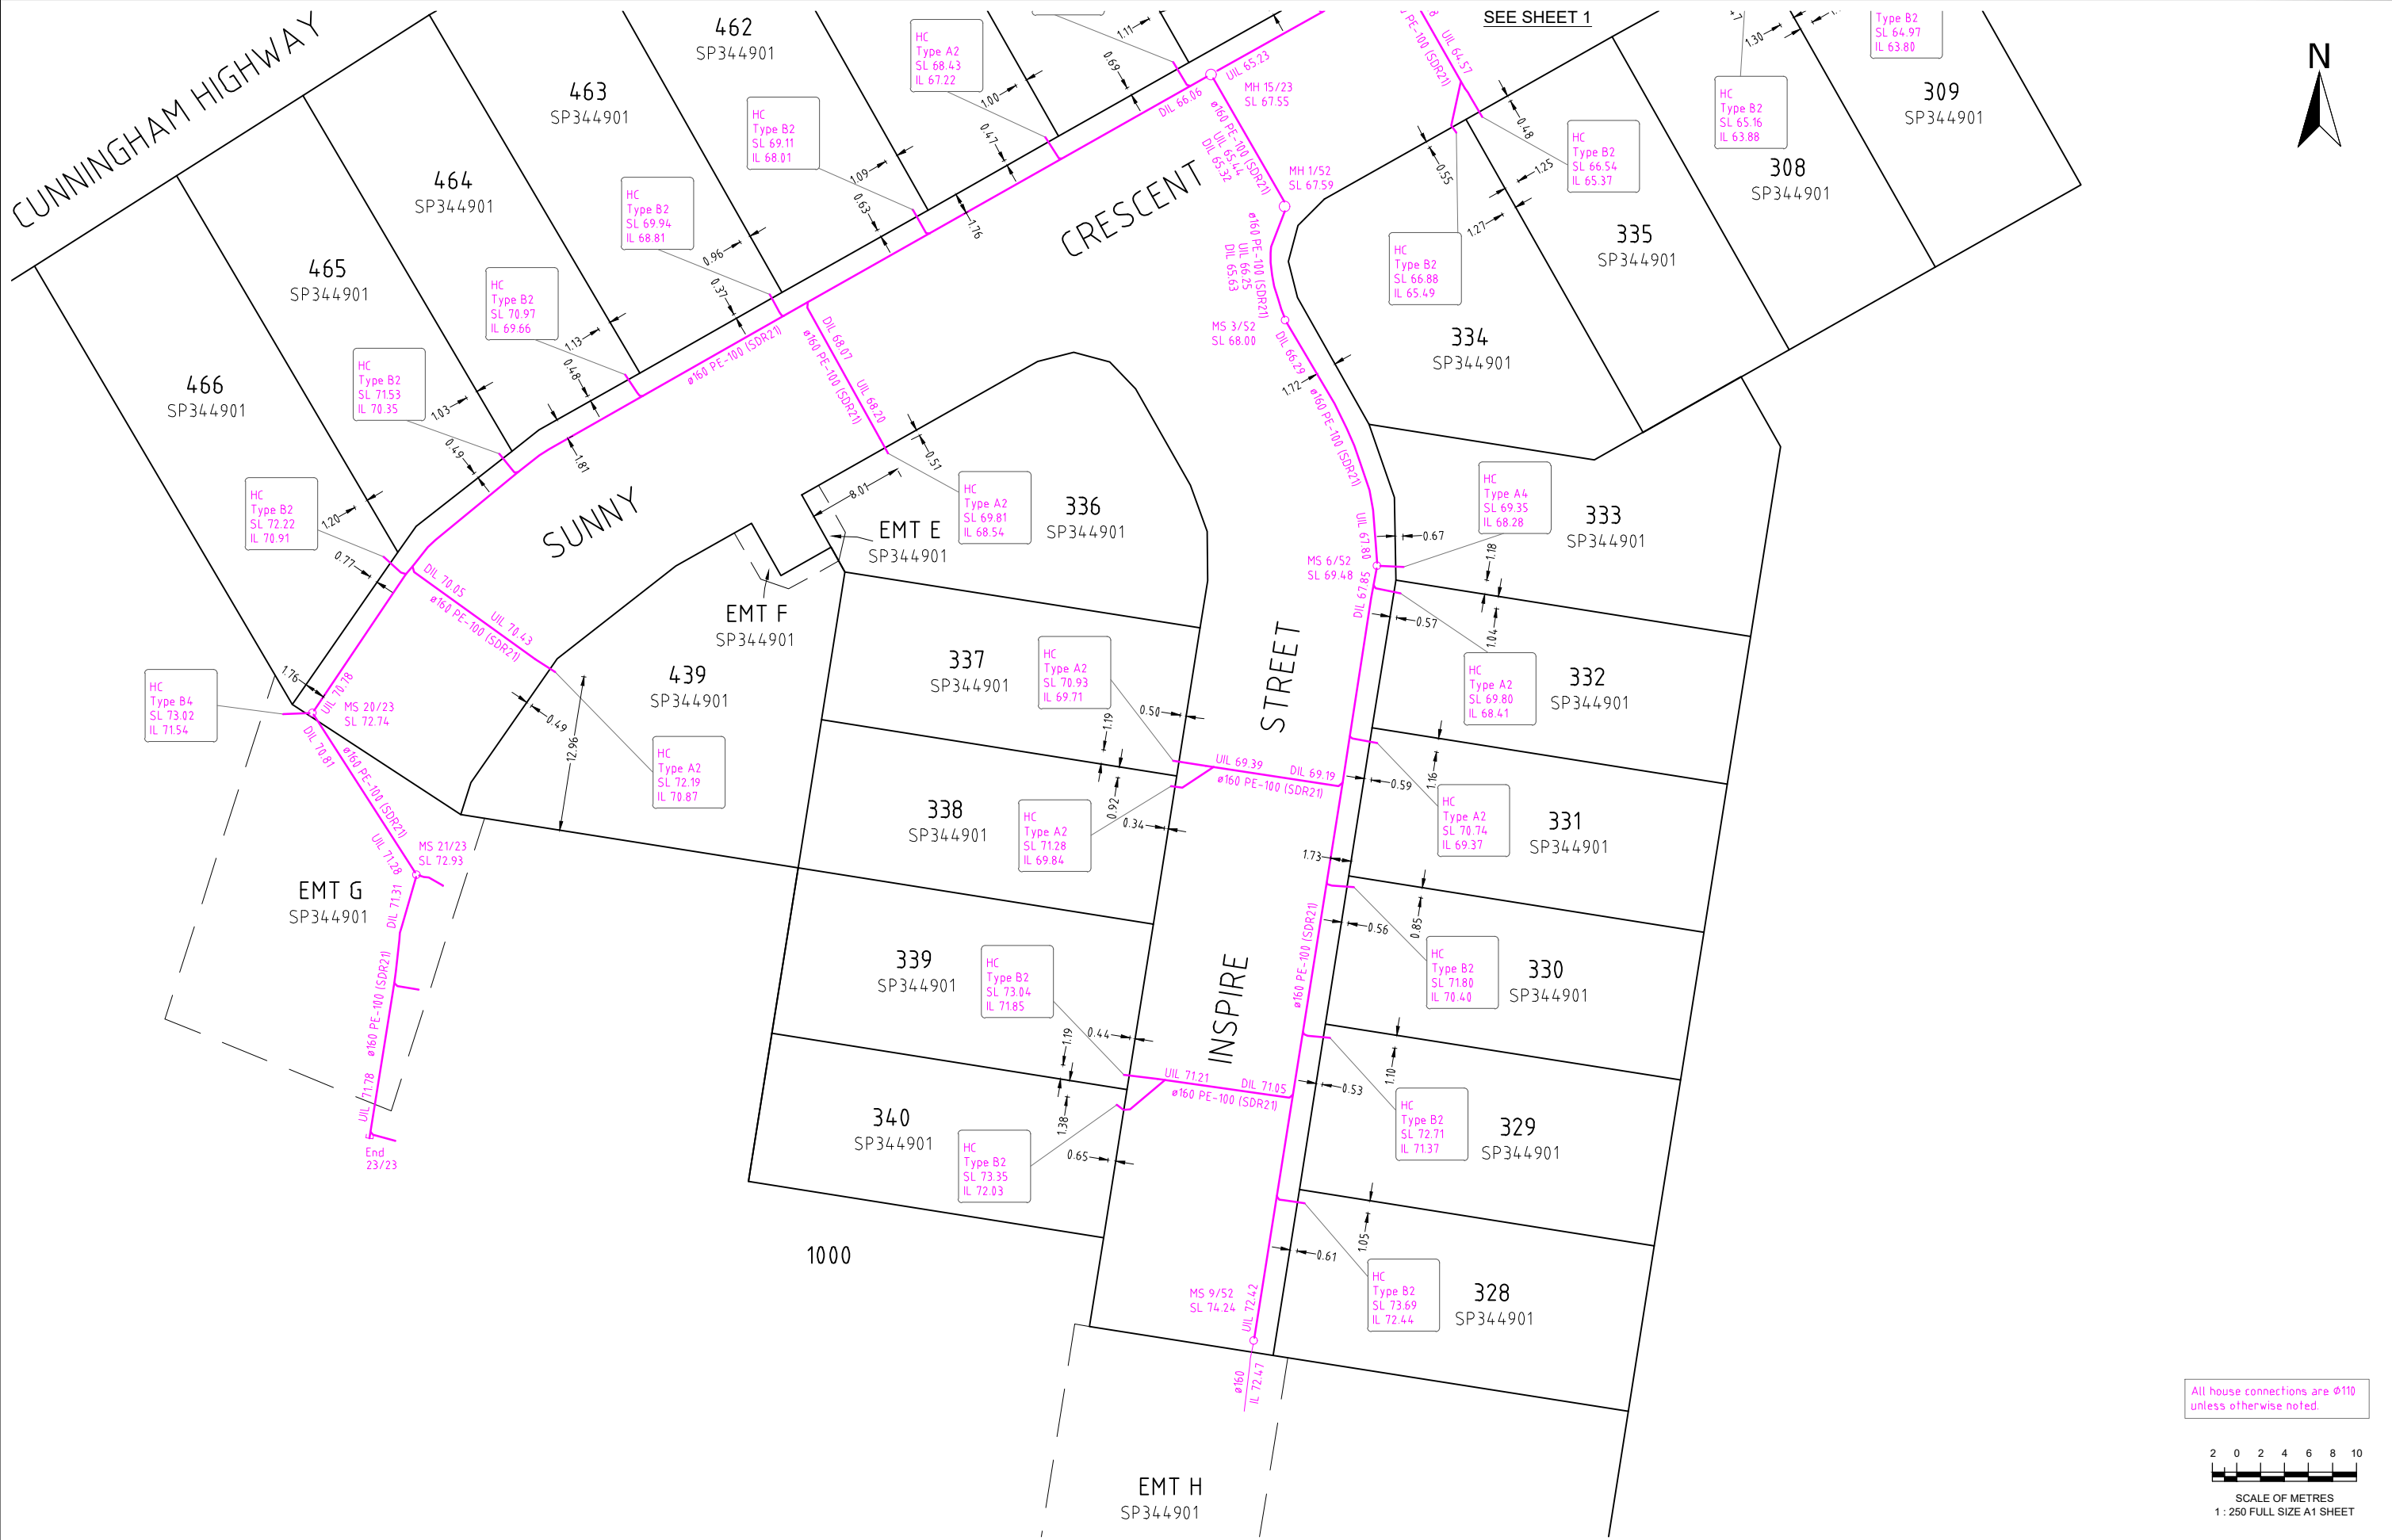

All house connections are Ø110 unless otherwise noted.

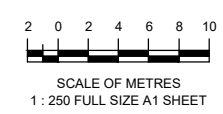

A1									

DRAWN	TG	29/08/2024
CHECKED	MK	02/09/2024
APPROVED		

saunders havill group
 Saunders Havill Group Pty Ltd ABN 84 664 597 949
 head office 2 Thompson St Bowen Hills Q 4006
 phone 8500 678 5462 web www.saundershavill.com.au
 ■ surveying ■ town planning ■ civil design ■ environmental management ■ landscape architecture



BELLEVUE ESTATE - STAGE 11
SUNNY CRESCENT, RIPLEY
PLAN OF ADAC SURVEY DATA
SEWERAGE RETICULATION 23-PNT-65217

DRAWING STATUS	
AS CONSTRUCTED	
SHEET 2 OF 2 SHEETS	
DRAWING NO.	REV.
	A