


KA - Denotes Kerb Adaptor

AS CONSTRUCTED

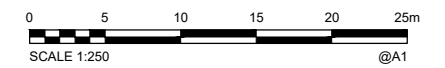

A1	INDEX	DATE	REVISIONS	DRAWN	CHECKED	PASSED
	A	03/09/2024	Builder's Issue			

DRAWN	TG	29.08.2024
CHECKED	MK	03.09.2024
PASSED		
INITIALS	DATE	


saunders havill group
 Brisbane Springfield
 head office 9 Thomson St Bowen Hills Q 4006
 phone 1300 423 5116 web www.saundershavill.com
 Drawing No: 9780 S 67 AC A

Colliers INTERNATIONAL

City of Ipswich


IPSWICH CITY COUNCIL
 AS CONSTRUCTED - ROADS & DRAINAGE
 BELLEVUE ESTATE - STAGE 11
 SUNNY CRESCENT, RIPLEY

SCALE	1:250
SHEET	1 OF 2 SHEETS
DRAWING NO.	

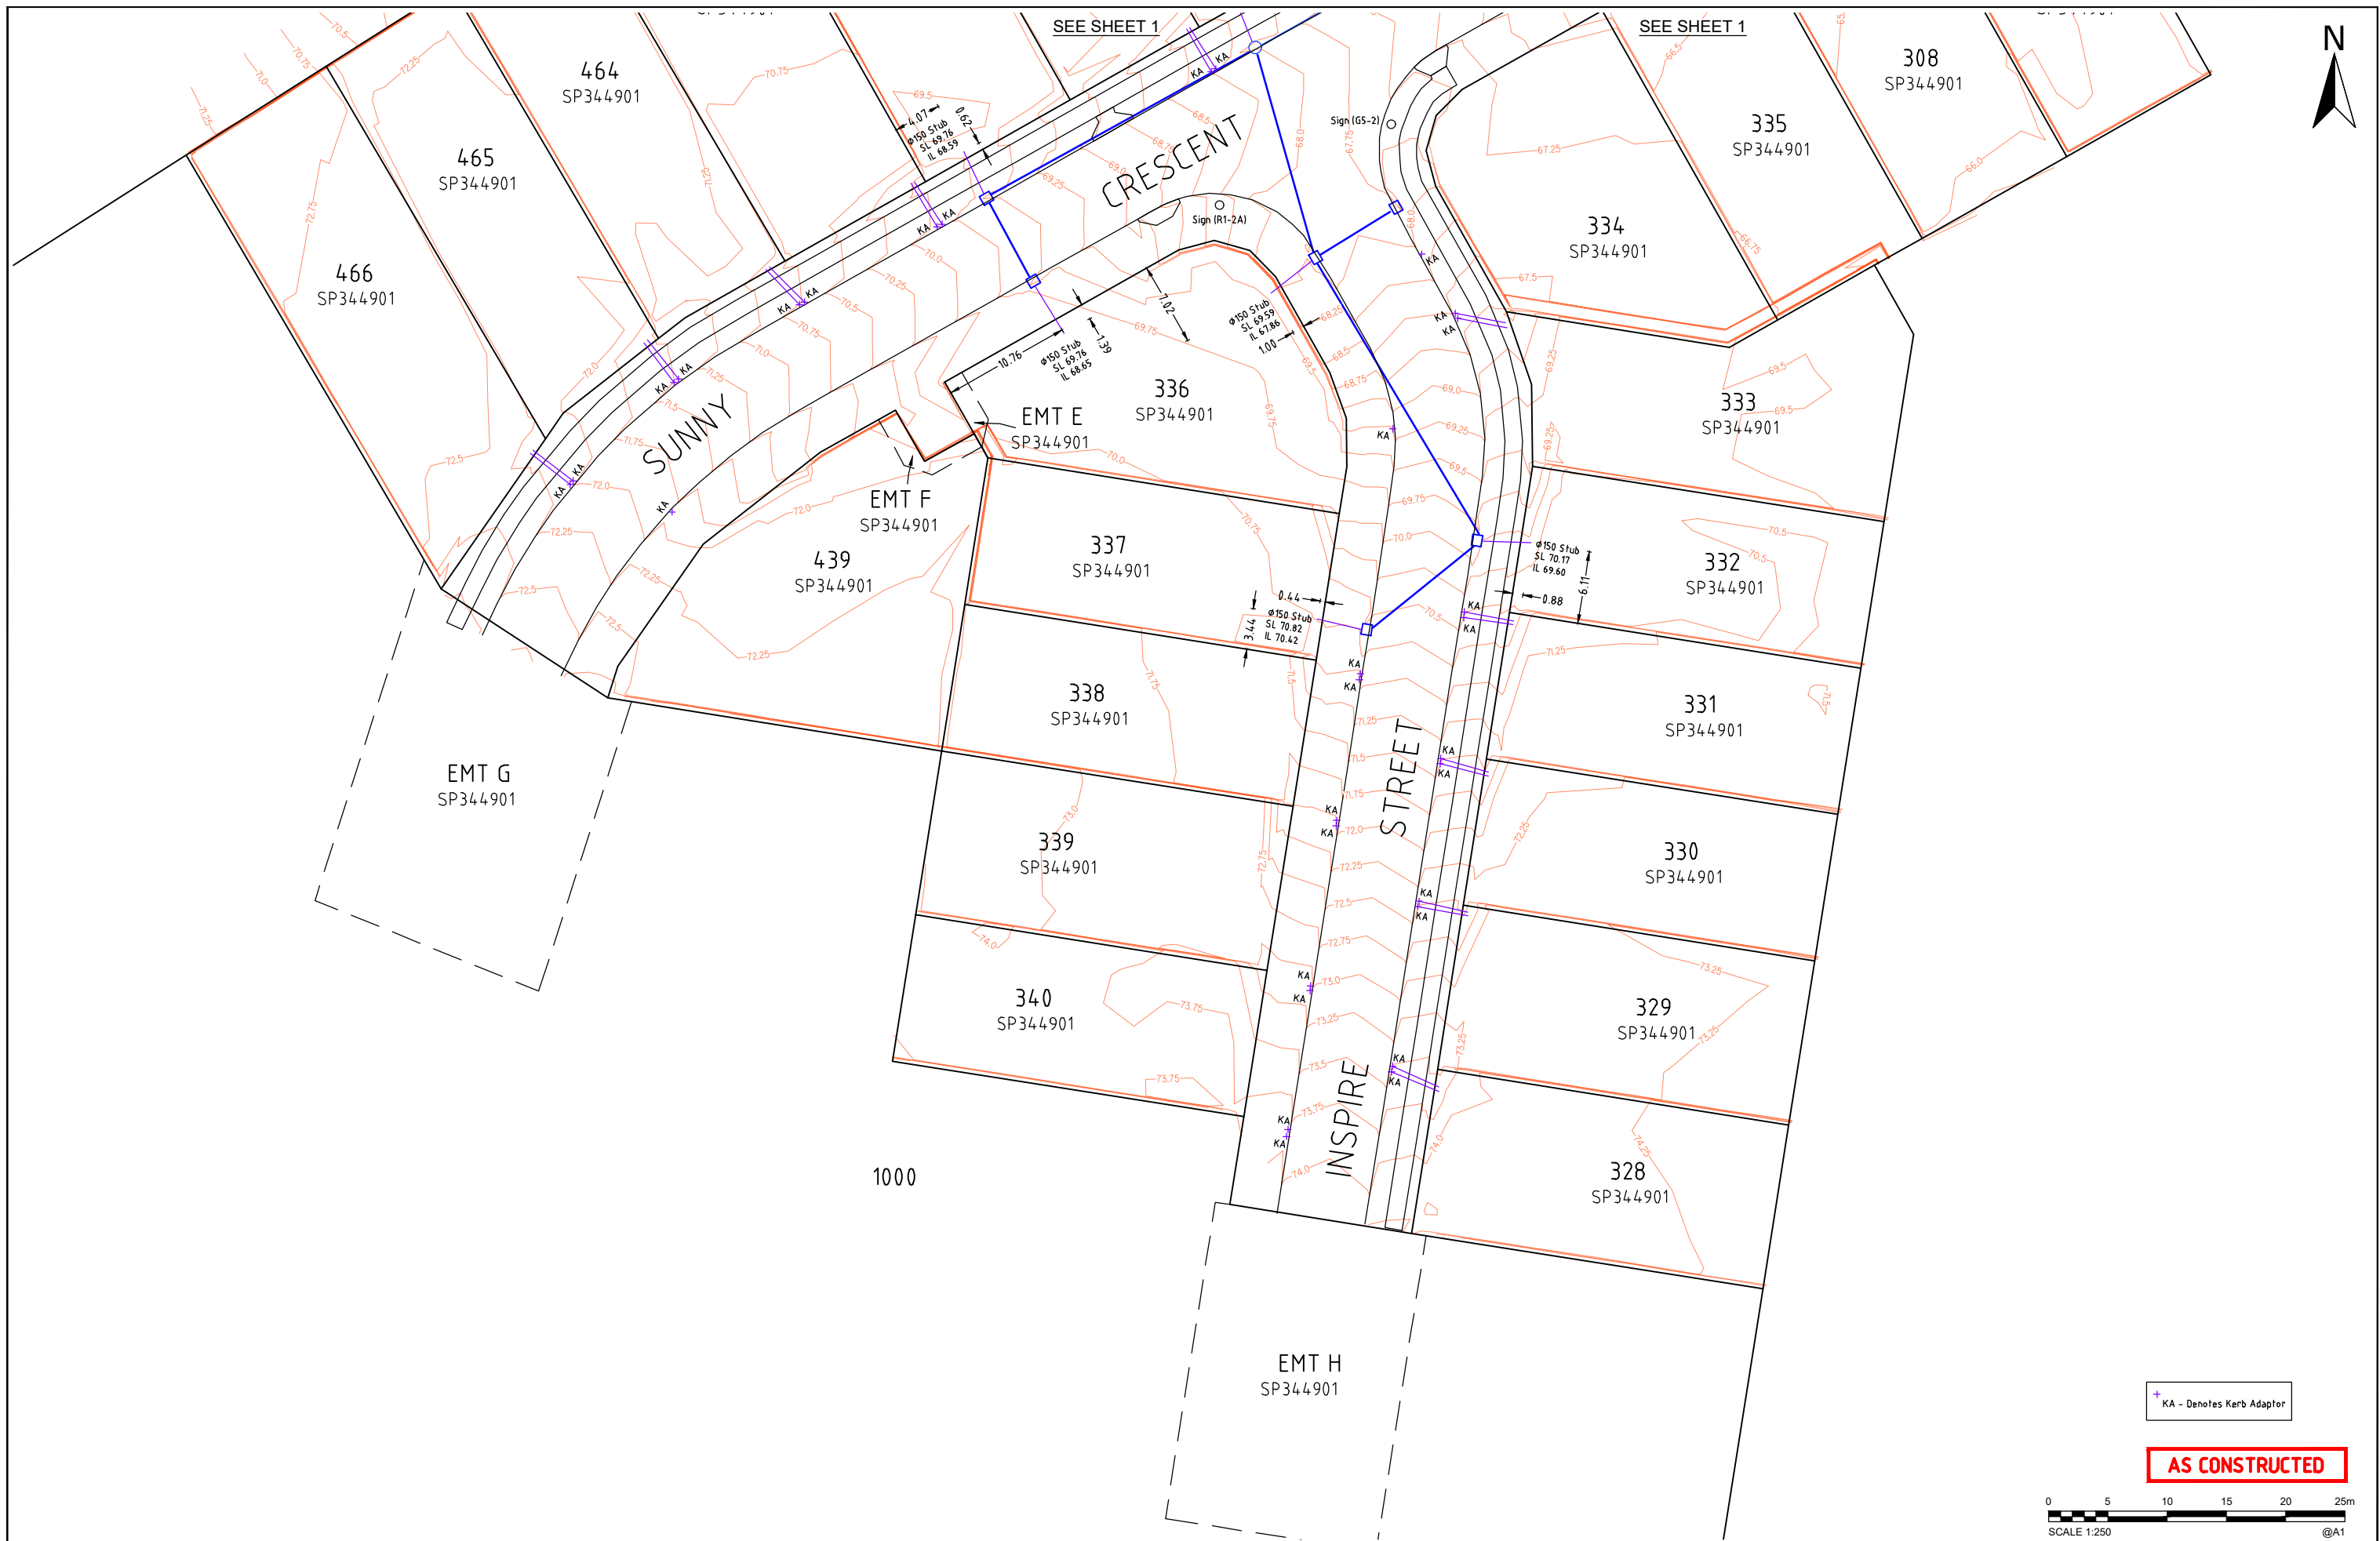

+ KA - Denotes Kerb Adaptor

AS CONSTRUCTED

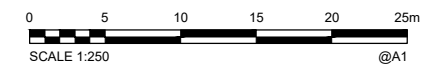

A1	INDEX	DATE	REVISIONS	DRAWN	CHECKED	PASSED
	A	03/09/2024	Builder's Issue			

DRAWN	TG	29.08.2024
CHECKED	MK	03.09.2024
PASSED		
INITIALS	DATE	

saunders havill group
 Brisbane Springfield
 head office 9 Thomson St Bowen Hills Q 4006
 phone 1300 623 5116 web www.saundershavill.com
 Drawing No: 9780 S 67 AC A

Colliers INTERNATIONAL

City of Ipswich

IPSWICH CITY COUNCIL
 AS CONSTRUCTED - ROADS & DRAINAGE
 BELLEVUE ESTATE - STAGE 11
 SUNNY CRESCENT, RIPLEY

SCALE	1:250
SHEET	2 OF 2 SHEETS
DRAWING NO.	