




1000



1000

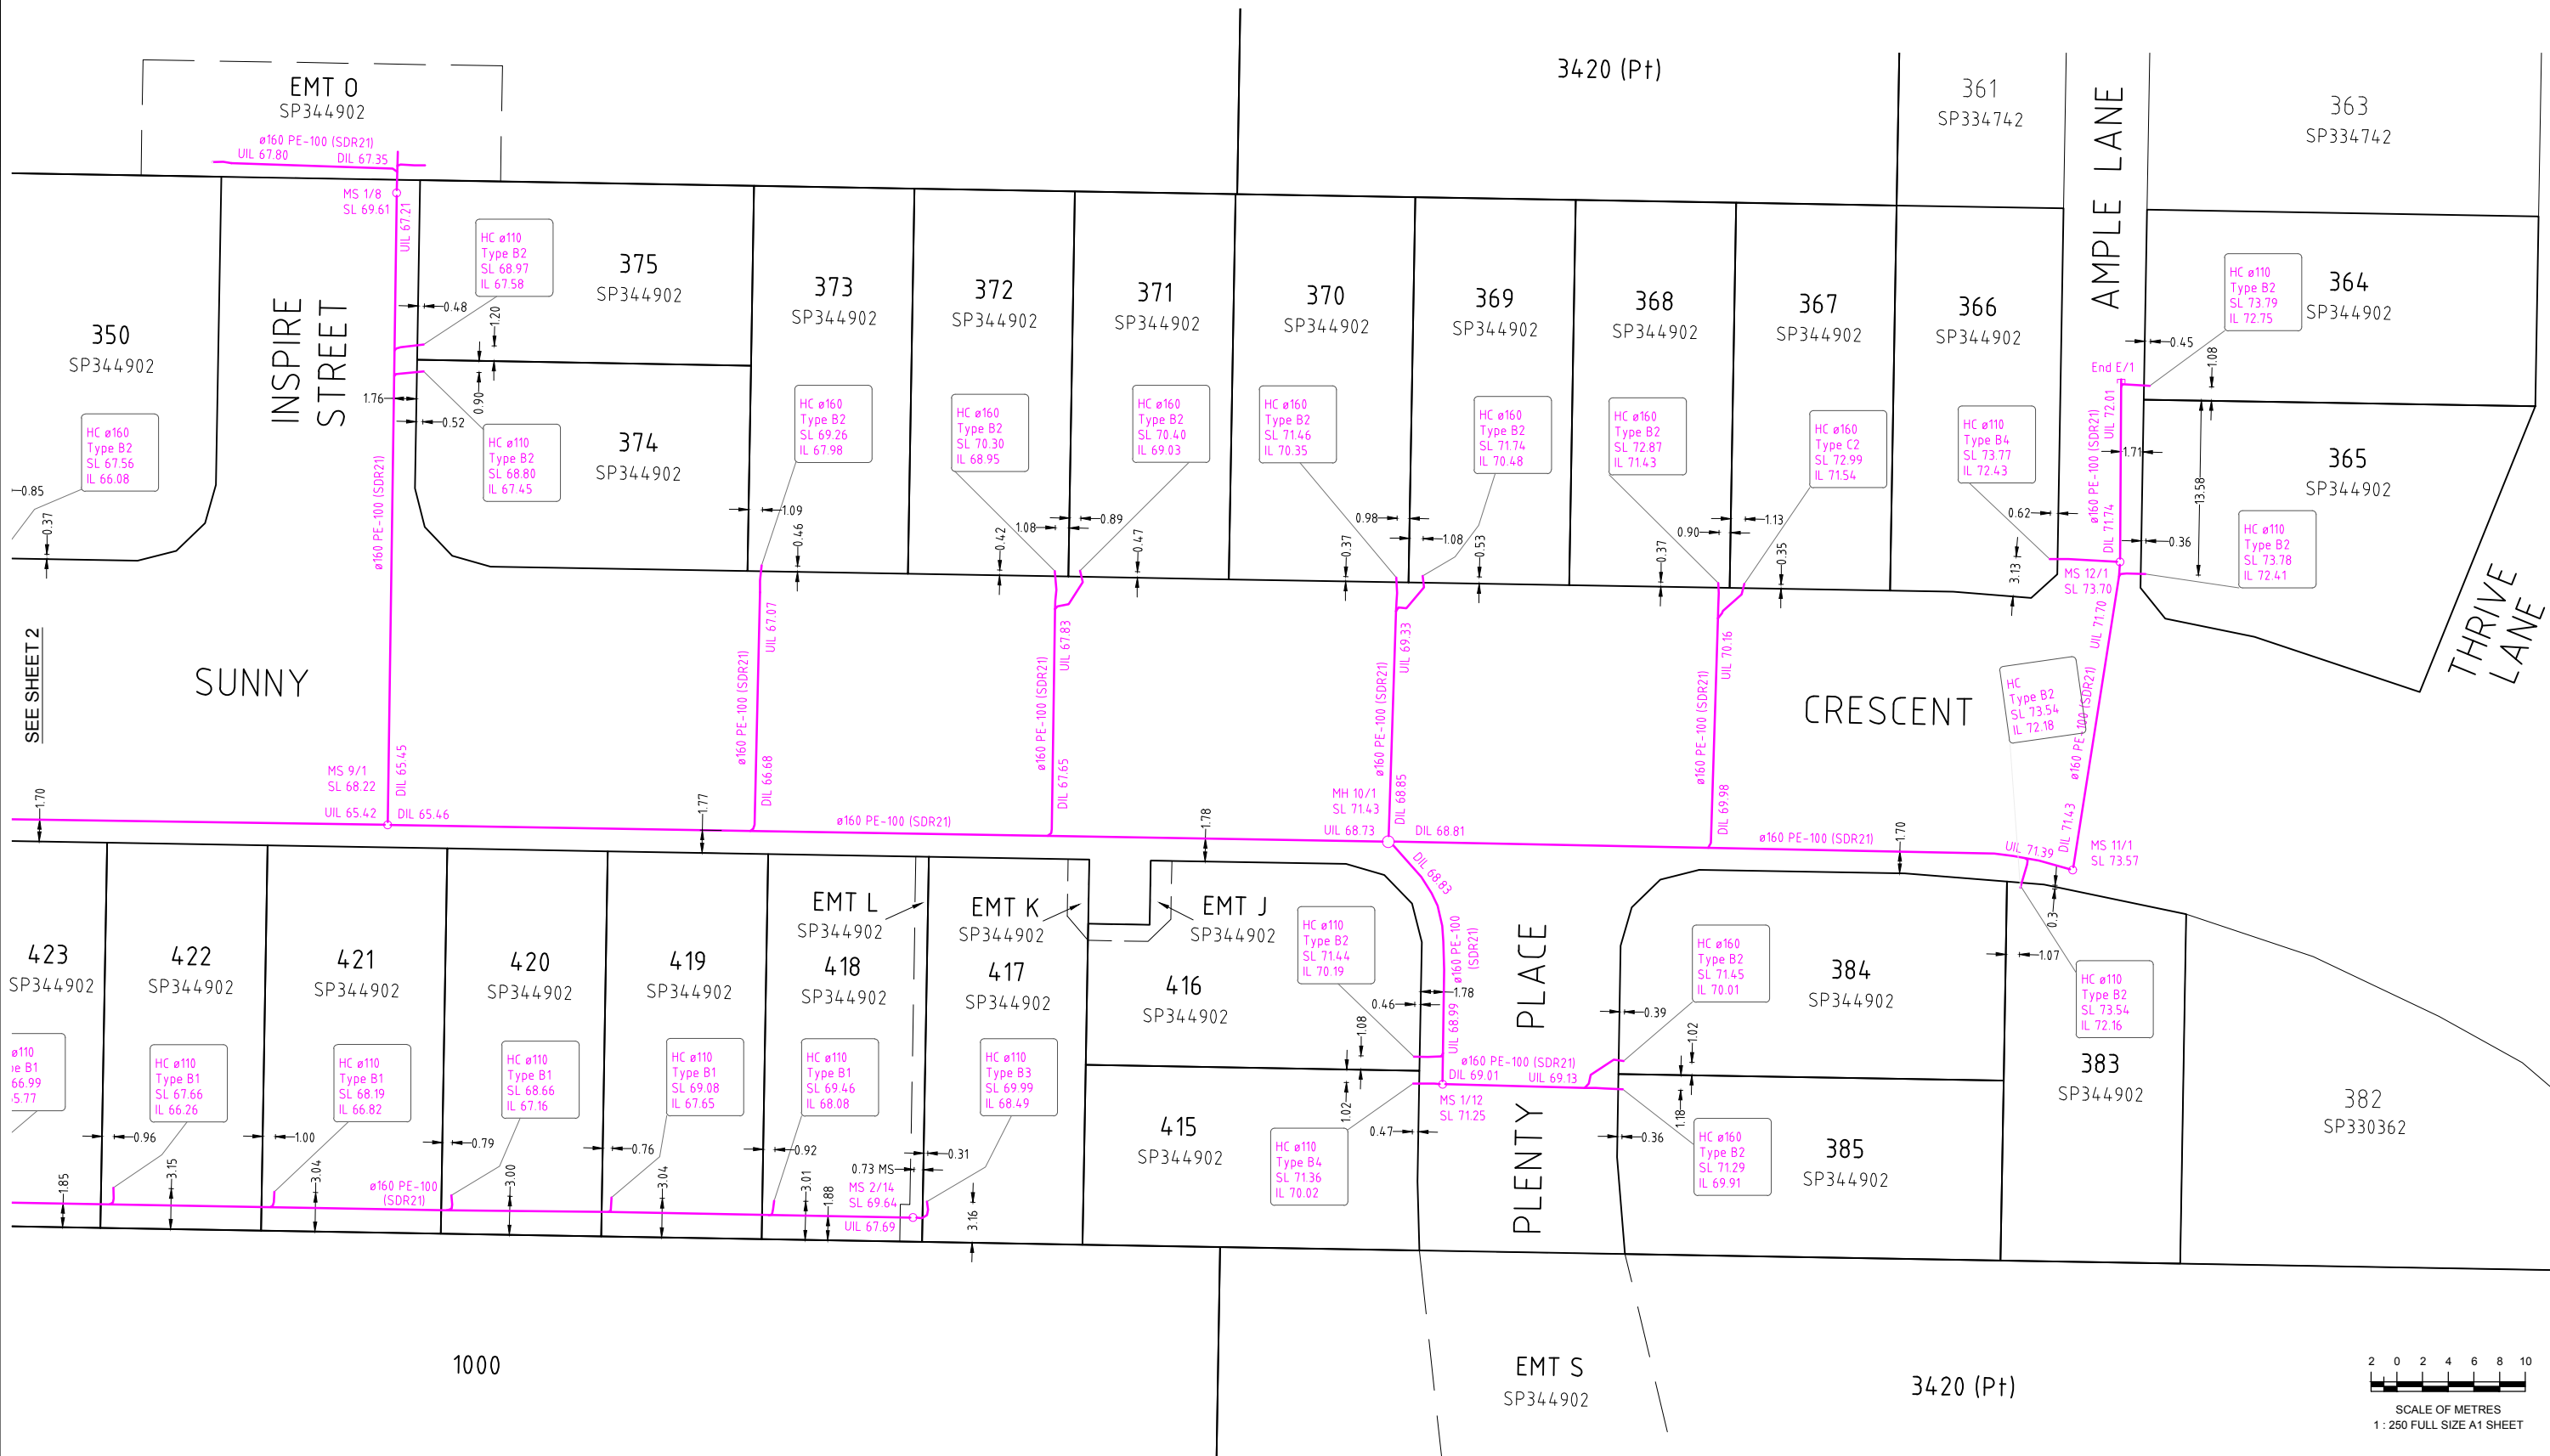

SCALE OF METRES
1 : 250 FULL SIZE A1 SHEET

A1

REV NO	DATE	REVISION PURPOSE / DESCRIPTION	DRAWN	RPEQ	RPEQ No
A	06.12.2024	Builders Issue			

DRAWN	TG	22.11.2024
CHECKED	CU	05.12.2024
APPROVED		
INITIALS		DATE


saunders havill group
 Saunders Havill Group Pty Ltd ABN 24 144 592 540
 head office 5 Thompson St Bowen Hills Q 4006
 phone 090 63 5HG web www.saundershavill.com
 ■ surveying ■ town planning ■ urban design ■ environmental management ■ landscape architecture

Drawing No: 9780 S 74 AC A - Builders Issue



BELLEVUE ESTATE - STAGE 12
 SUNNY CRESCENT, RIPLEY
 PLAN OF ADAC SURVEY DATA
 SEWERAGE RETICULATION 23-PNT-67464

DRAWING STATUS AS CONSTRUCTED	
SHEET 1 OF 2 SHEETS	
DRAWING NO.	REV.
	A

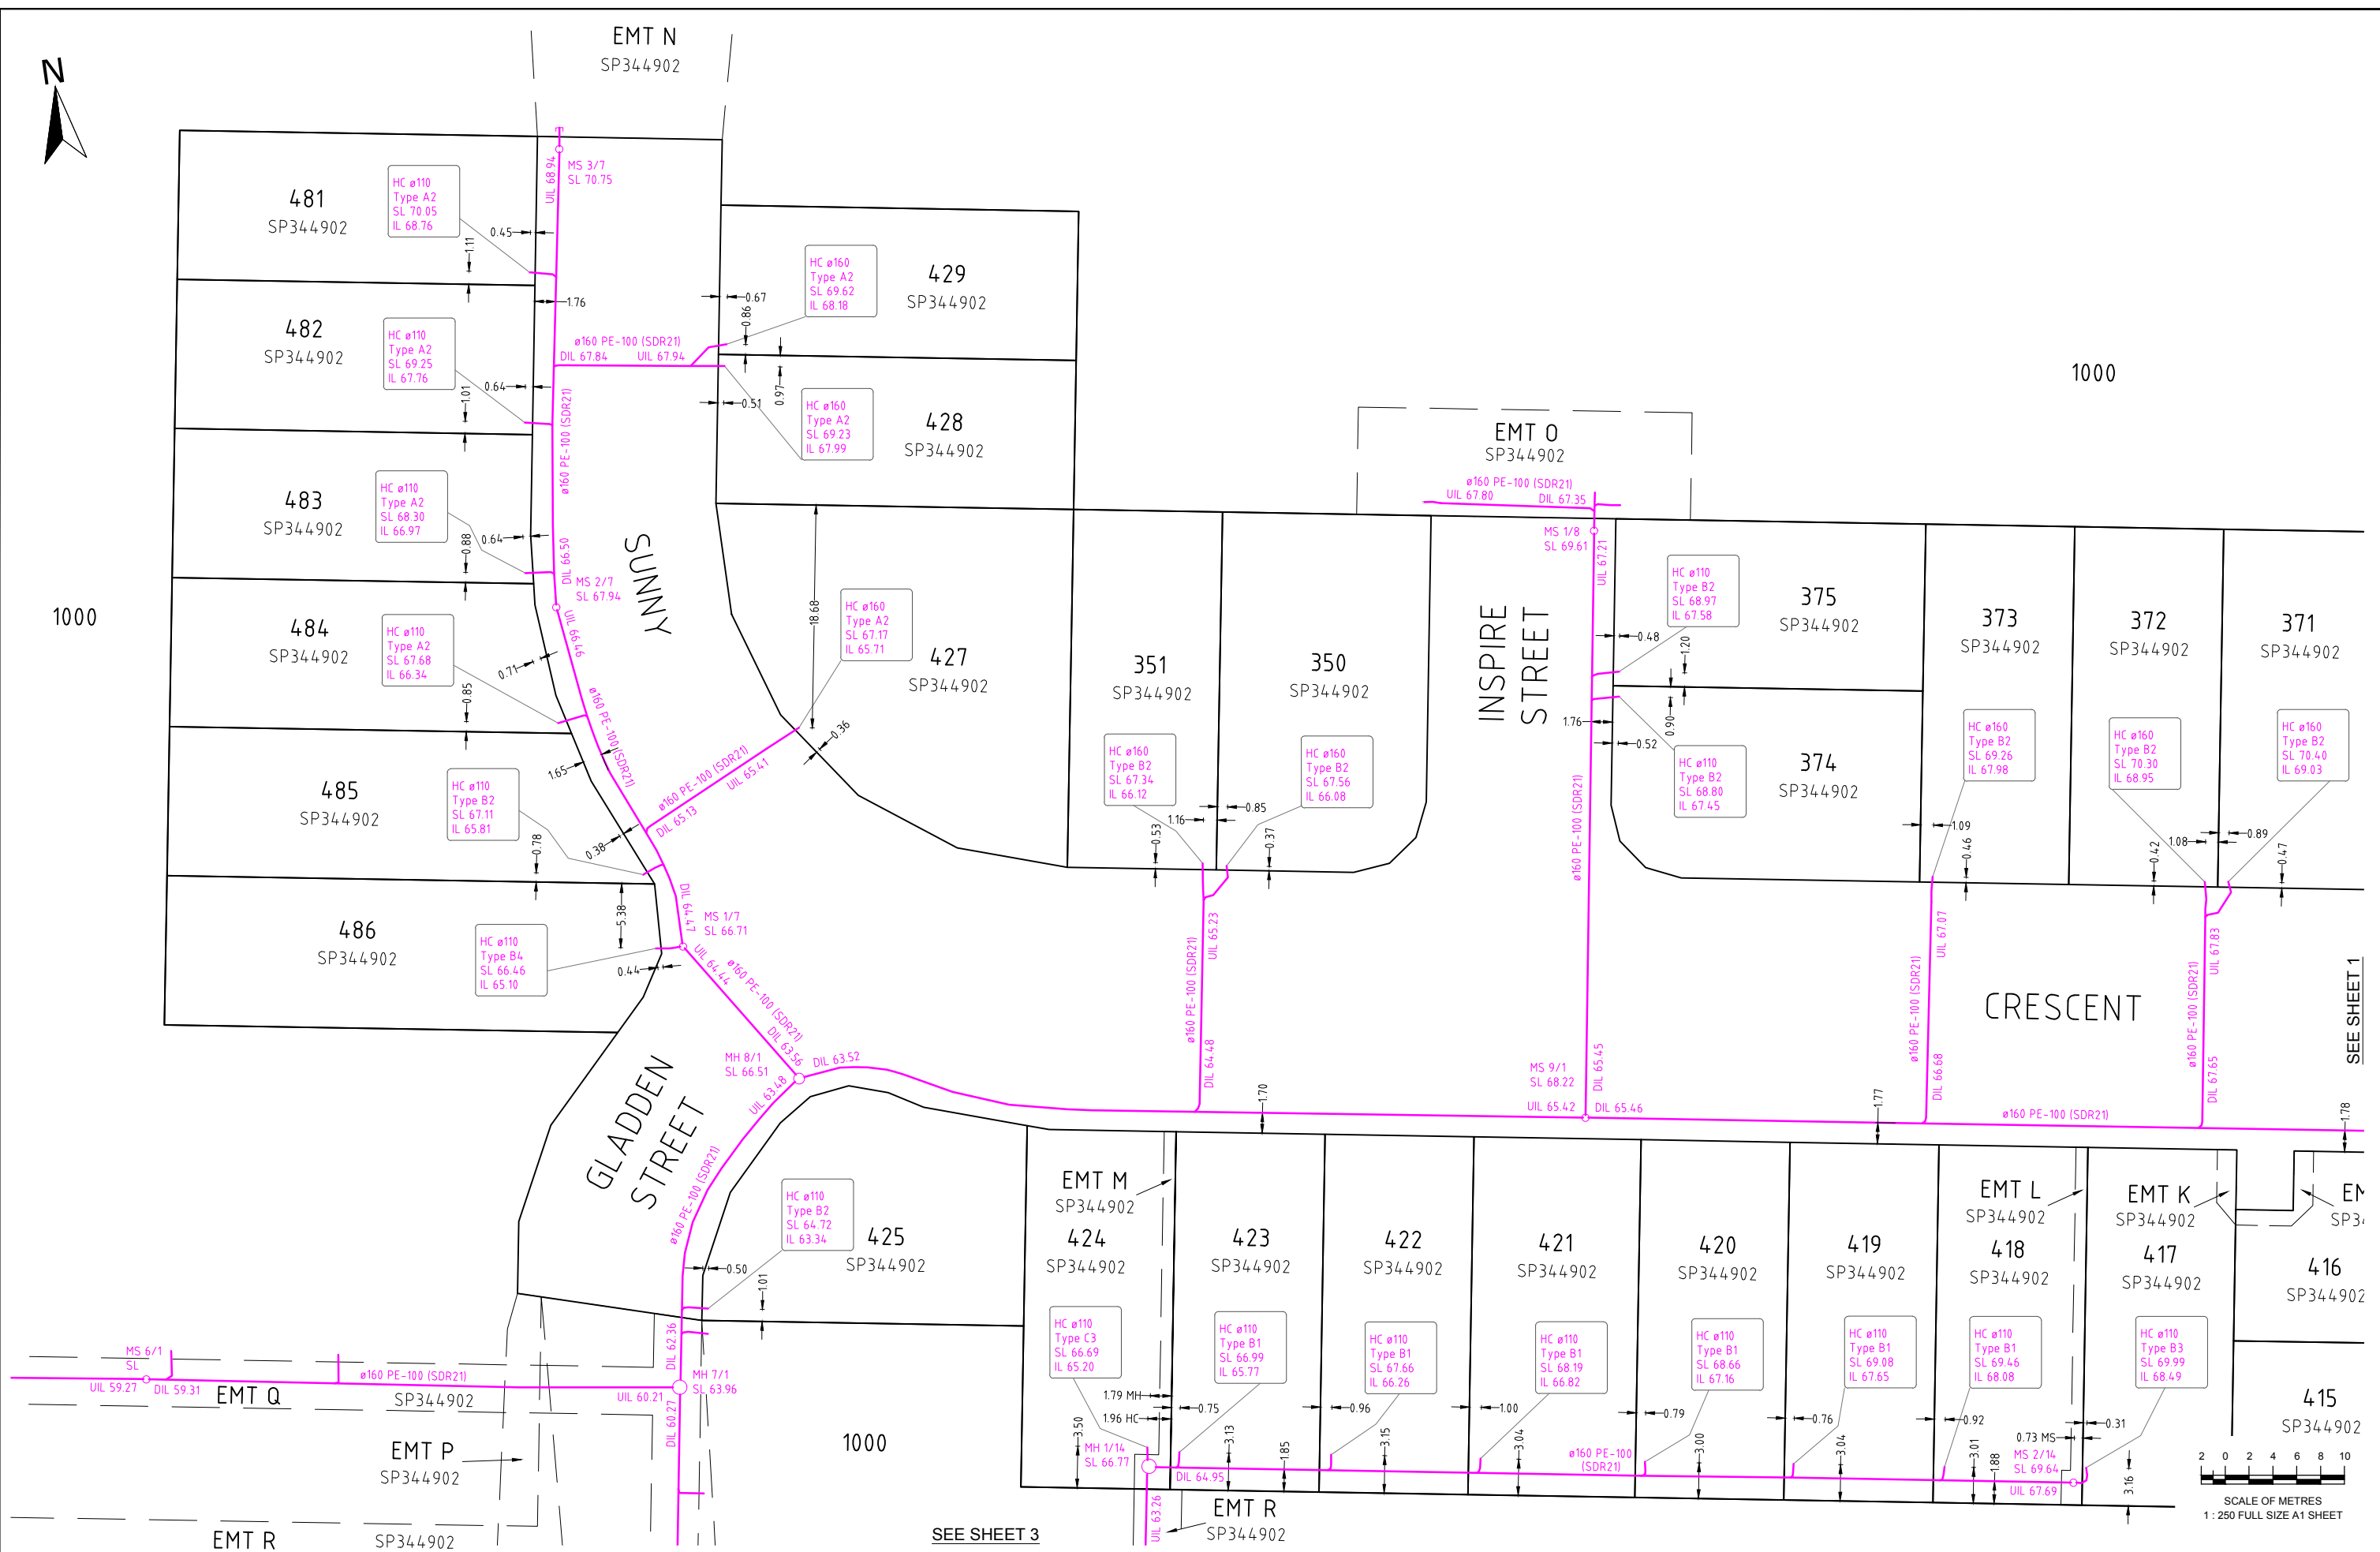


1000

1000

SEE SHEET 1

SEE SHEET 3

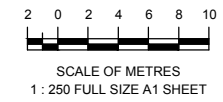

A1	REV NO	DATE	REVISION PURPOSE / DESCRIPTION	DRAWN	RPEQ	RPEQ No	DRAWN	RPEQ	RPEQ No	INITIALS	DATE
	A	06.12.2024	Builders Issue								

DRAWN	TG	22.11.2024
CHECKED	CU	05.12.2024
APPROVED		



BELLEVUE ESTATE - STAGE 12
SUNNY CRESCENT, RIPLEY
 PLAN OF ADAC SURVEY DATA
 SEWERAGE RETICULATION 23-PNT-67464


DRAWING STATUS AS CONSTRUCTED	
SHEET 2 OF 2 SHEETS	
DRAWING NO.	REV.
	A



1000



WATER FITTINGS LEGEND	
	Hydrant
	Valve
	Bend
	Water Fitting
	Dead End Cap
	Reducer
	Water Meter
	Conduit Crossing and Service Pipe

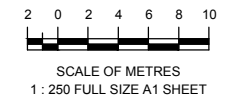

A1

REV NO	DATE	REVISION PURPOSE / DESCRIPTION	DRAWN	RPEQ	RPEQ No	INITIALS	DATE
A	06.12.2024	Builders Issue					


DRAWN	TG	22.11.2024
CHECKED	CU	05.12.2024
APPROVED		

SH saunders havill group
 Saunders Havill Group Pty Ltd ABN 24 144 572 540
 head office 9 Thompson St Bowen Hills Q 4006
 phone 0900 833 516 web www.saundershavill.com
 ■ surveying ■ town planning ■ urban design ■ environmental management ■ landscape architecture
 Drawing No: 9780 S 74 AC A - Builders Issue



BELLEVUE ESTATE - STAGE 12
 SUNNY CRESCENT, RIPLEY
 PLAN OF ADAC SURVEY DATA
 WATER RETICULATION 23-PNT-67464

DRAWING STATUS	
AS CONSTRUCTED	
SHEET 1 OF 2 SHEETS	
DRAWING NO.	REV.
	A

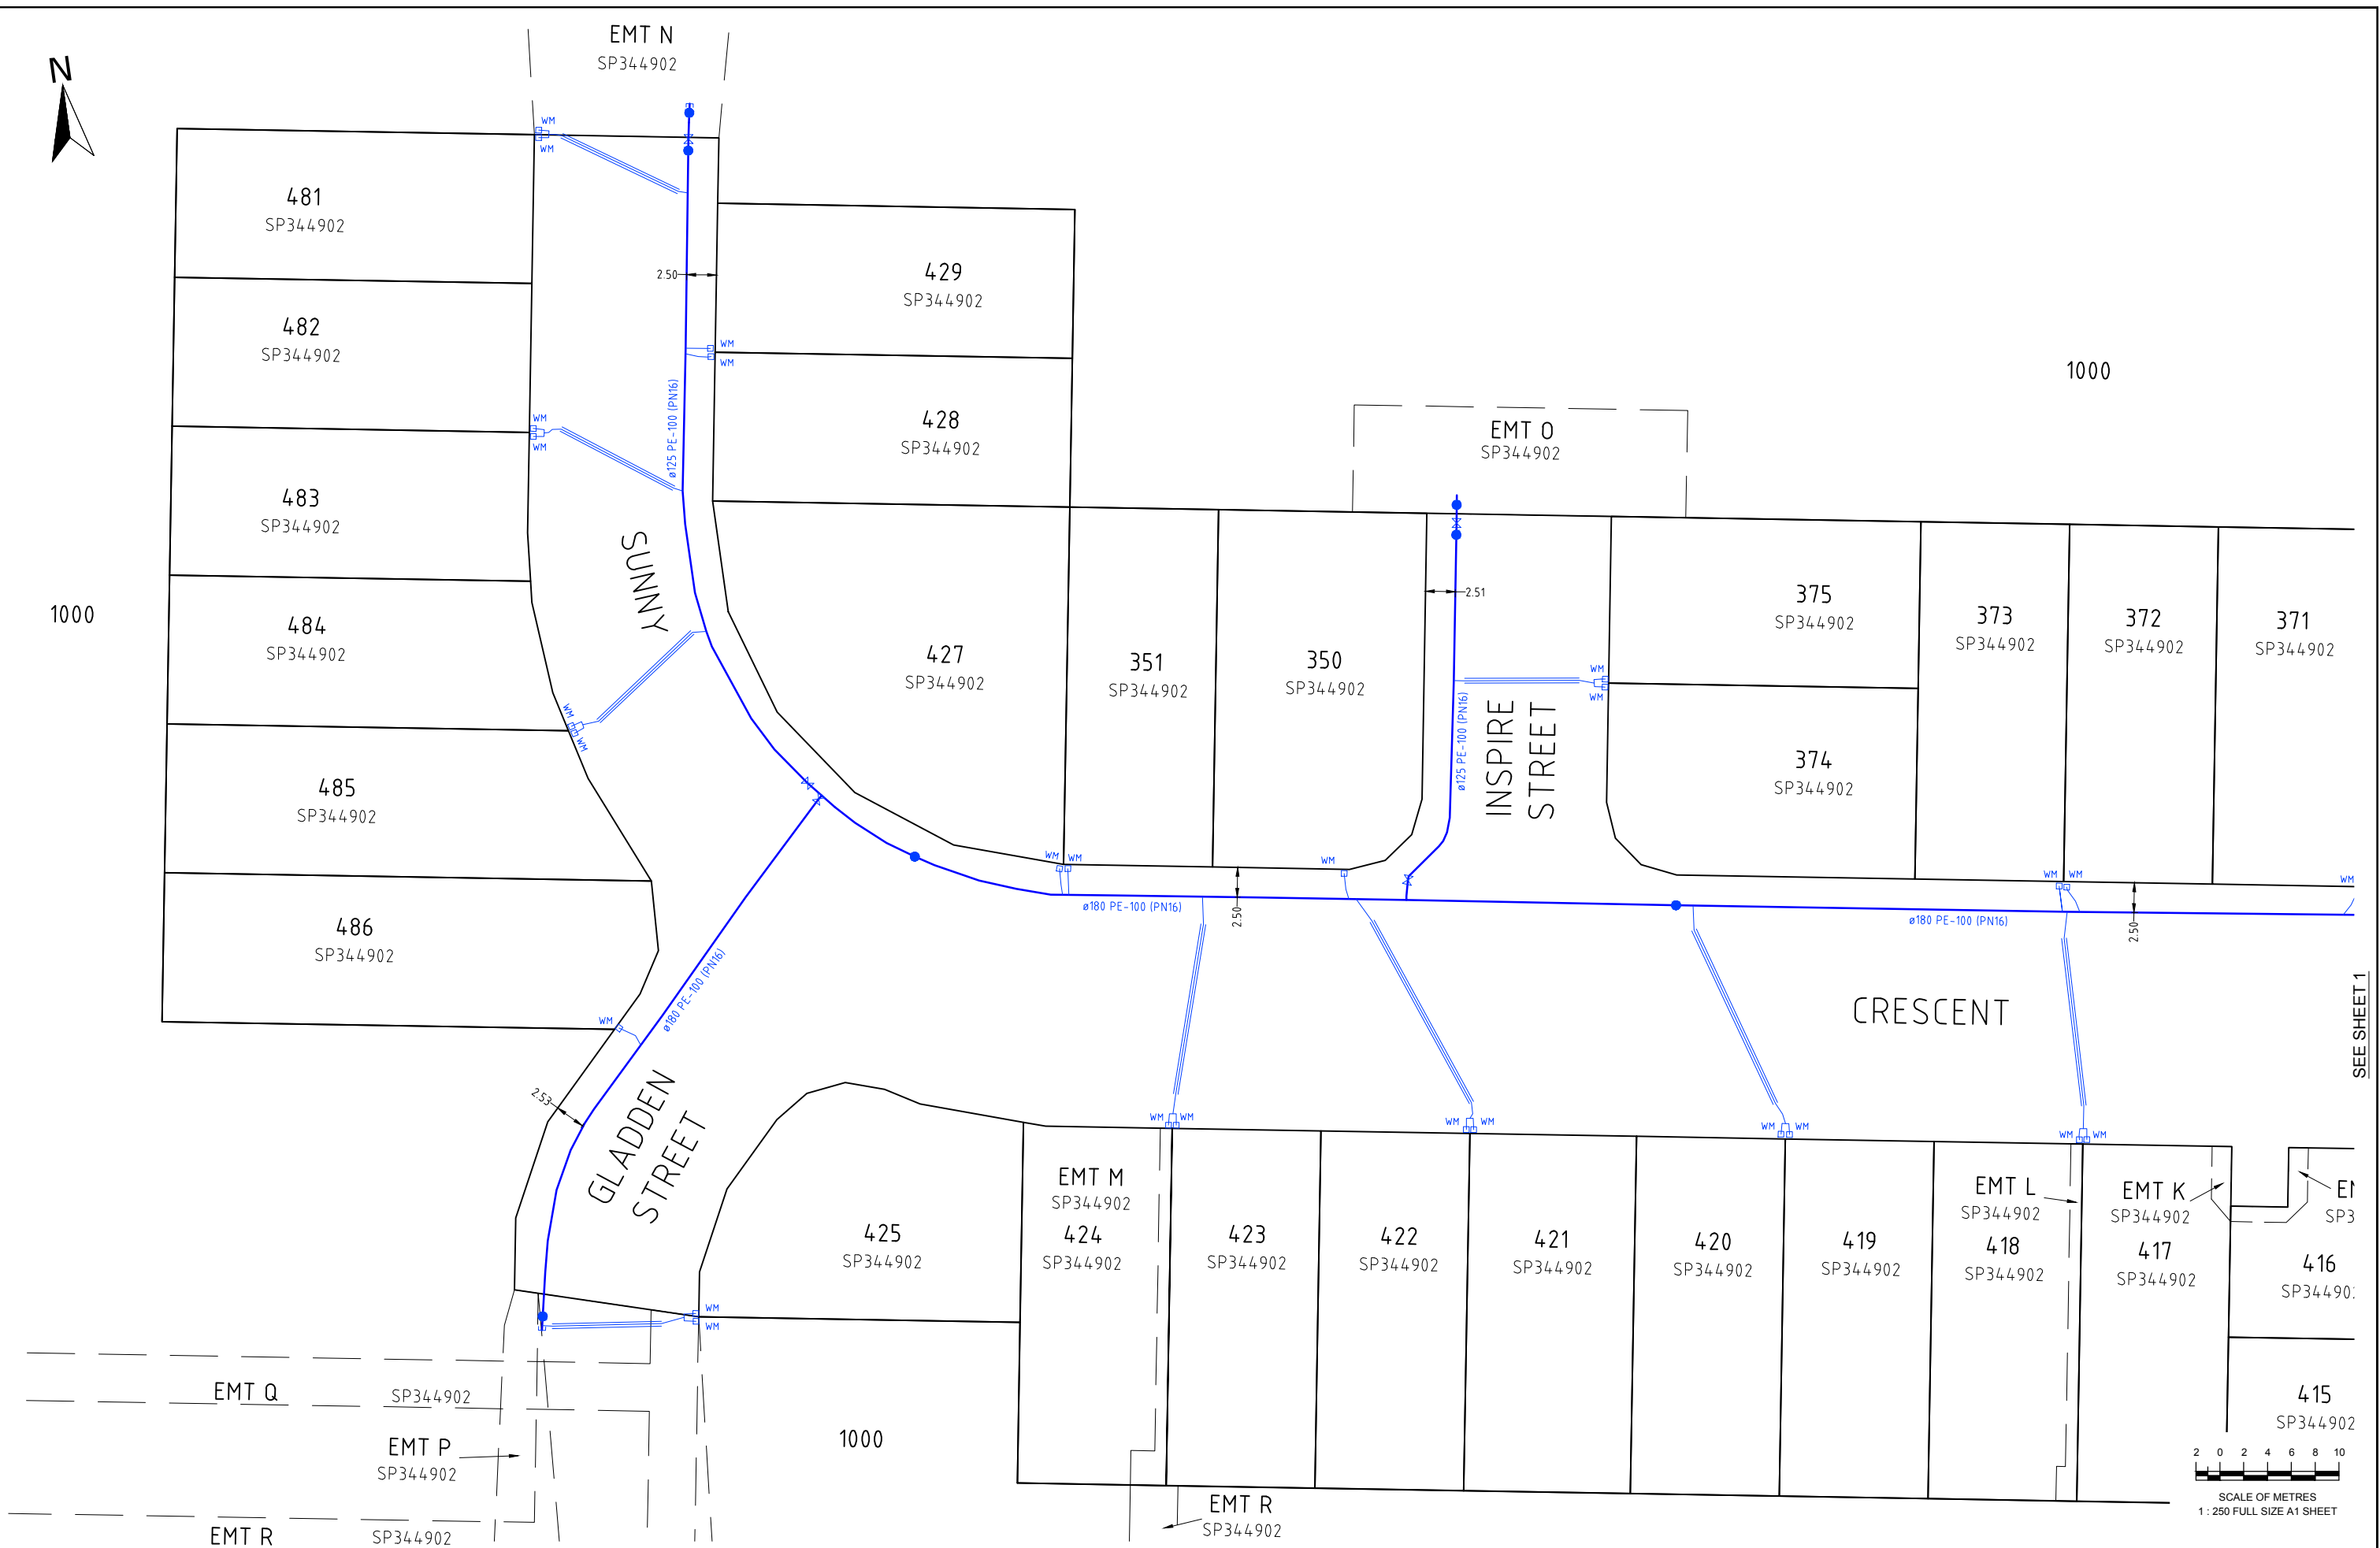

SEE SHEET 1

A1

REV NO	DATE	REVISION PURPOSE / DESCRIPTION	DRAWN	RPEQ	RPEQ No
A	06.12.2024	Builders Issue			

DRAWN	TG	22.11.2024
CHECKED	CU	05.12.2024
APPROVED		
INITIALS		DATE

SH saunders havill group
 Saunders Havill Group Pty Ltd ABN 54 144 572 540
 head office 9 Thompson St Bowen Hills Q 4006
 phone 0900 493 516 web www.saundershavill.com
 ■ surveying ■ town planning ■ urban design ■ environmental management ■ landscape architecture

Drawing No: 9780 S 74 AC A - Builders Issue



BELLEVUE ESTATE - STAGE 12
 SUNNY CRESCENT, RIPLEY
 PLAN OF ADAC SURVEY DATA
 WATER RETICULATION 23-PNT-67464

DRAWING STATUS	
AS CONSTRUCTED	
SHEET 2 OF 2 SHEETS	
DRAWING NO.	REV.
	A