




SEE SHEET 2

AS CONSTRUCTED

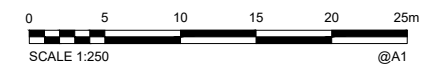

A1	INDEX	DATE	REVISIONS	DRAWN	CHECKED	PASSED
	A	17/01/2025	Builder's Issue			

DRAWN	CM	29.11.2024
CHECKED	CU	10.01.2025
PASSED		
INITIALS		DATE


**saunders havill group**  
 Brisbane Springfield  
 head office 9 Thompson St Bowen Hills Q 4006  
 phone 1900 423 SHS web www.saundershavill.com  
 Drawing No: 9780 S 76 AC A

**Colliers INTERNATIONAL**


**City of Ipswich**

**IPSWICH CITY COUNCIL**  
 AS CONSTRUCTED - ROADS & DRAINAGE  
 BELLEVUE ESTATE - STAGE 12  
 SUNNY CRESCENT, RIPLEY

SCALE	1:250
SHEET	1 OF 2 SHEETS
DRAWING NO.	

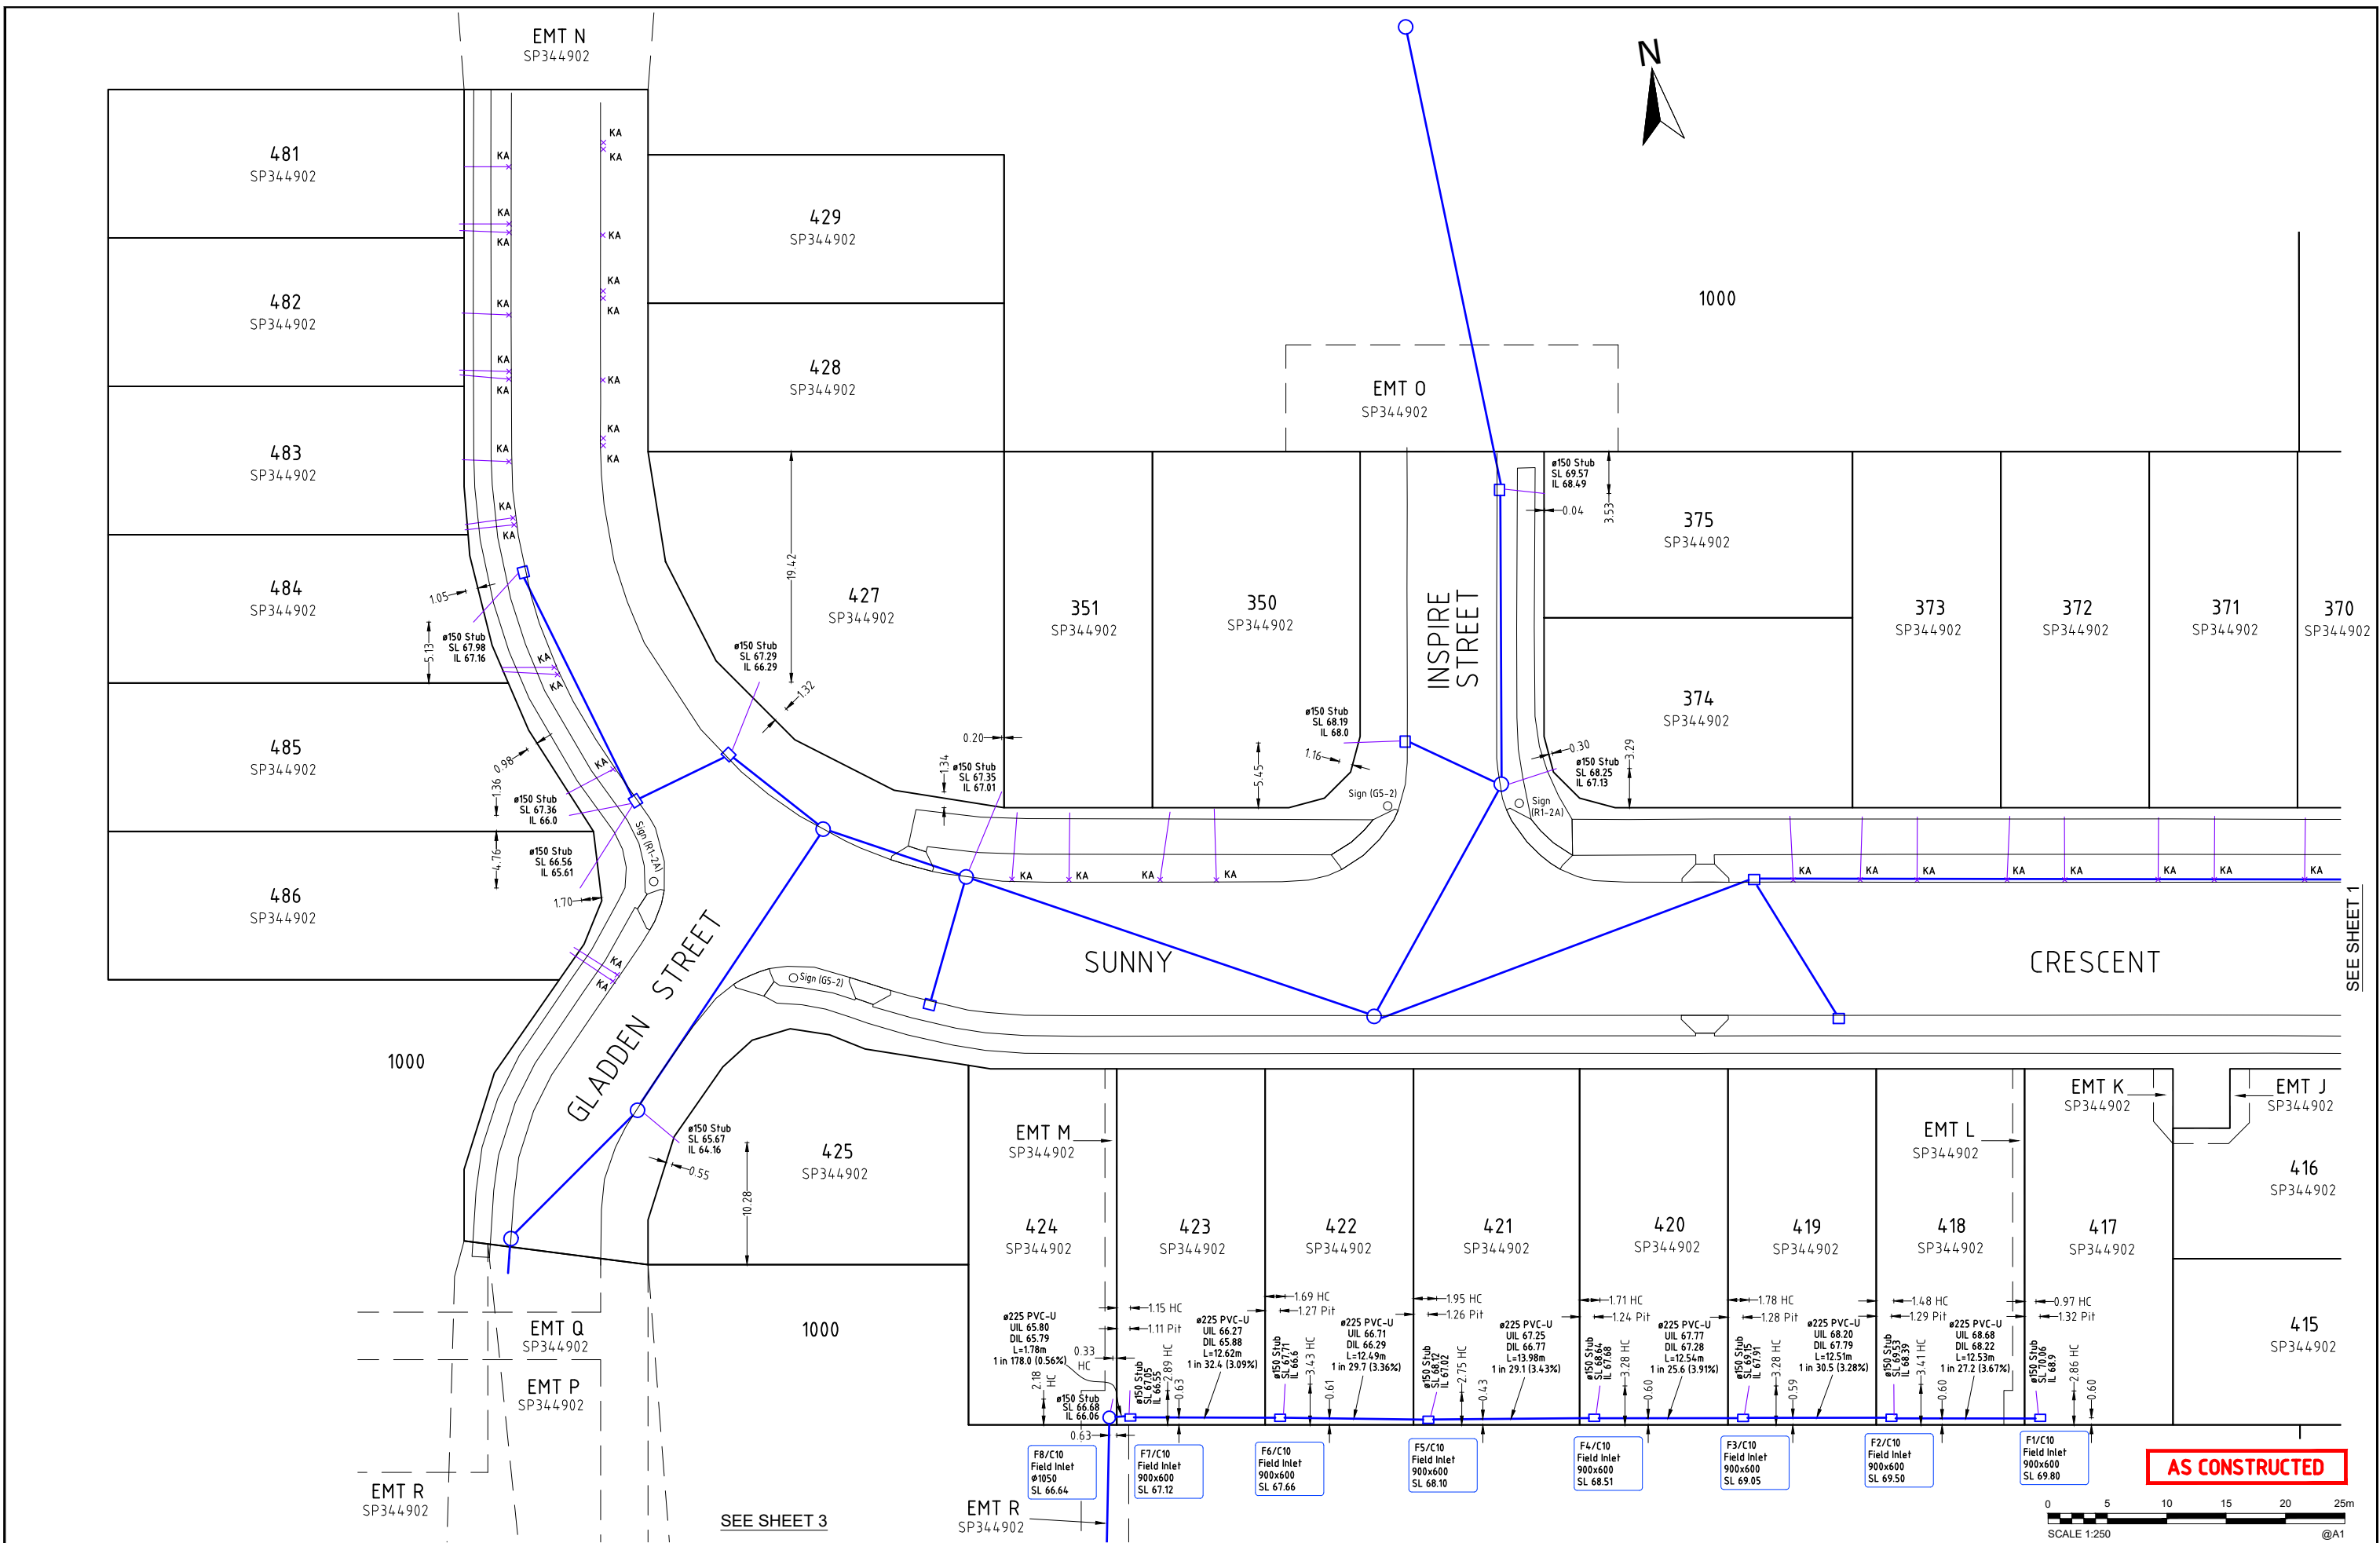

**AS CONSTRUCTED**

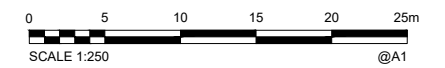

A1	INDEX	DATE	REVISIONS	DRAWN	CHECKED	PASSED
	A	17/01/2025	Builder's Issue			

DRAWN	CM	29.11.2024
CHECKED	CU	10.01.2025
PASSED		
INITIALS		DATE

**saunders havill group**  
 Brisbane Springfield  
 head office 9 Thompson St Bowen Hills Q 4006  
 phone 1900 123 SHS web www.saundershavill.com  
 Drawing No: 9780 S 76 AC A

**Colliers INTERNATIONAL**

**City of Ipswich**

**IPSWICH CITY COUNCIL**  
 AS CONSTRUCTED - ROADS & DRAINAGE  
 BELLEVUE ESTATE - STAGE 12  
 SUNNY CRESCENT, RIPLEY

SCALE	1:250
SHEET	2 OF 2 SHEETS
DRAWING NO.	