

A1

REV NO	DATE	REVISION PURPOSE / DESCRIPTION	DRAWN	RPEQ	RPEQ No
A	19.12.2024	Builders Issue			


DRAWN	CM	11.12.2024
CHECKED	CU	12.12.2024
APPROVED		

saunders havill group
 Saunders Havill Group Pty Ltd ABN 24 144 592 940
 head office 5 Thompson St Bowen Hills Q 4006
 phone: 090 423 5141 web: www.saundershavill.com
 ■ surveying ■ town planning ■ urban design ■ environmental management ■ landscape architecture

UrbanUtilities

BELLEVUE ESTATE - STAGE 13
LIVELY STREET, RIPLEY
PLAN OF ADAC SURVEY DATA
SEWERAGE RETICULATION 23-PNT-67465

DRAWING STATUS AS CONSTRUCTED	
SHEET 1 OF 1 SHEETS	
DRAWING NO.	REV. A

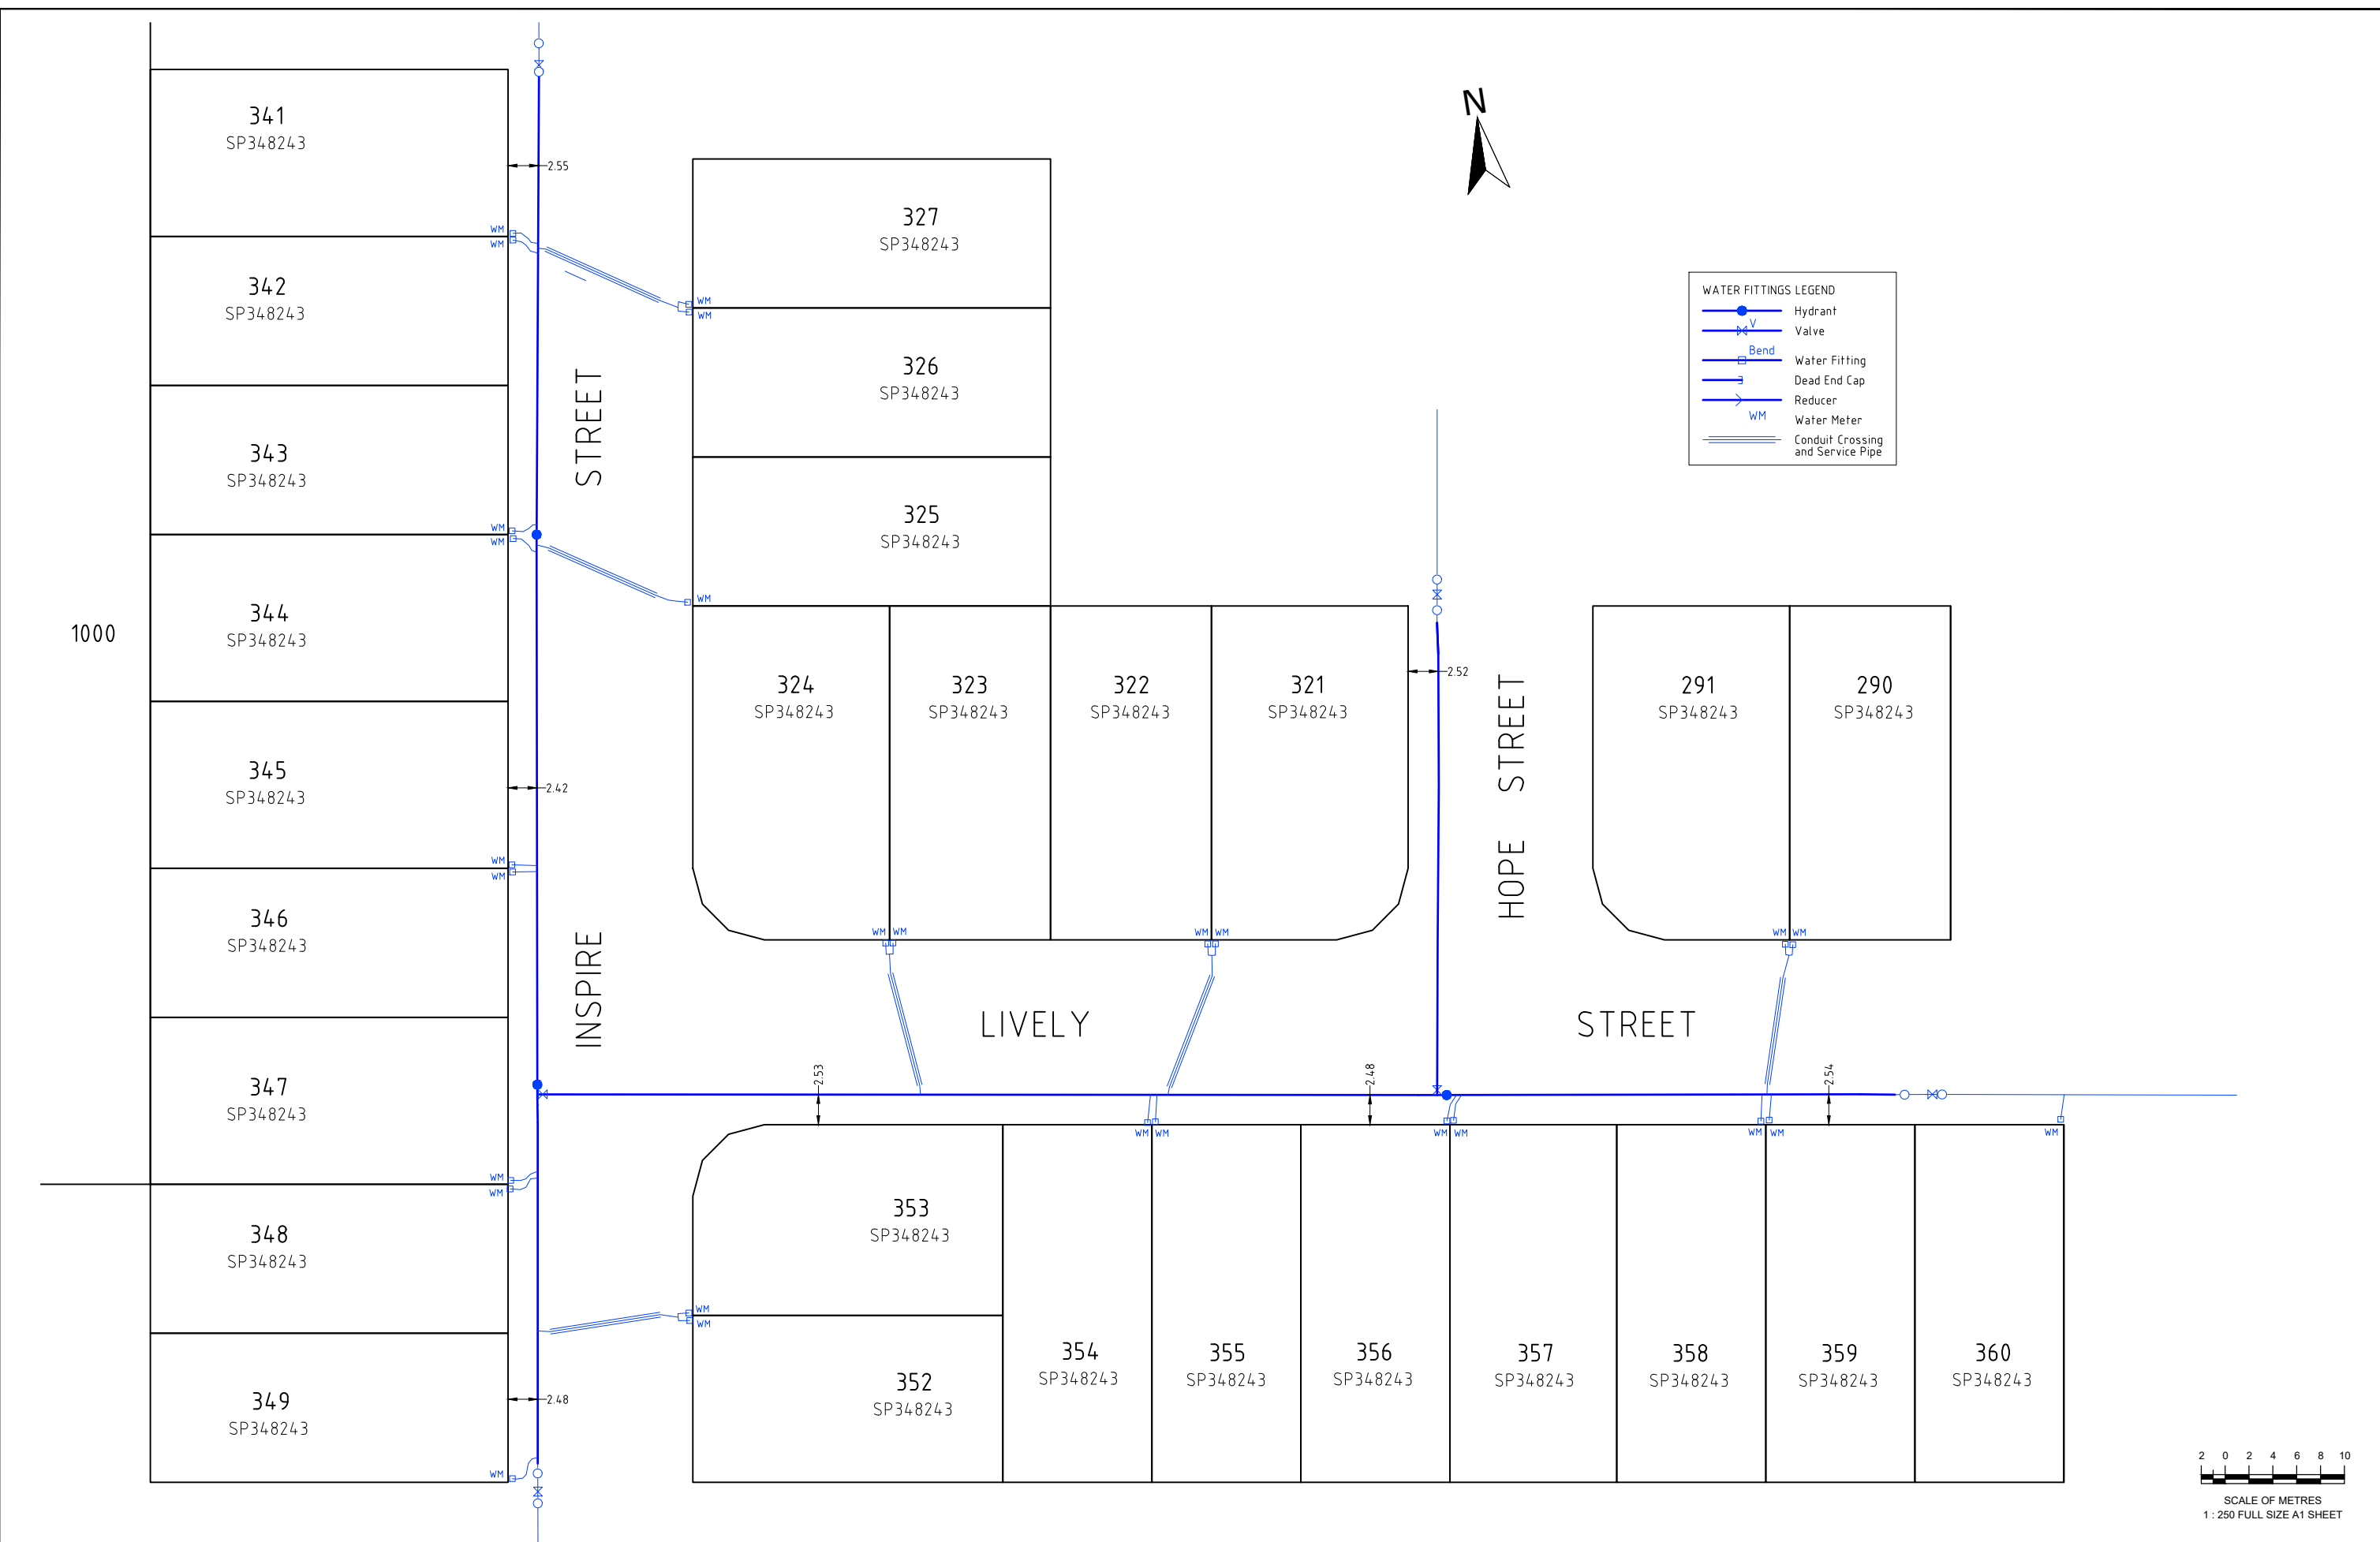

A1

REV NO	DATE	REVISION PURPOSE / DESCRIPTION	DRAWN	RPEQ	RPEQ No
A	12.12.2024	Builders Issue			

DRAWN	CM	11.12.2024
CHECKED	CU	12.12.2024
APPROVED		

saunders havill group
 Saunders Havill Group Pty Ltd ABN 24 144 592 949
 head office 9 Thompson St Bowen Hills Q 4006
 phone: 1800 423 SHG web: www.saundershavill.com
 ■ surveying ■ town planning ■ urban design ■ environmental management ■ landscape architecture
 Drawing No: 9780 S 77 AC A - Builders Issue



BELLEVUE ESTATE - STAGE 13
LIVELY STREET, RIPLEY
PLAN OF ADAC SURVEY DATA
WATER RETICULATION 23-PNT-67465

DRAWING STATUS AS CONSTRUCTED	
SHEET 1 OF 1 SHEETS	
DRAWING NO.	REV. A