





1000

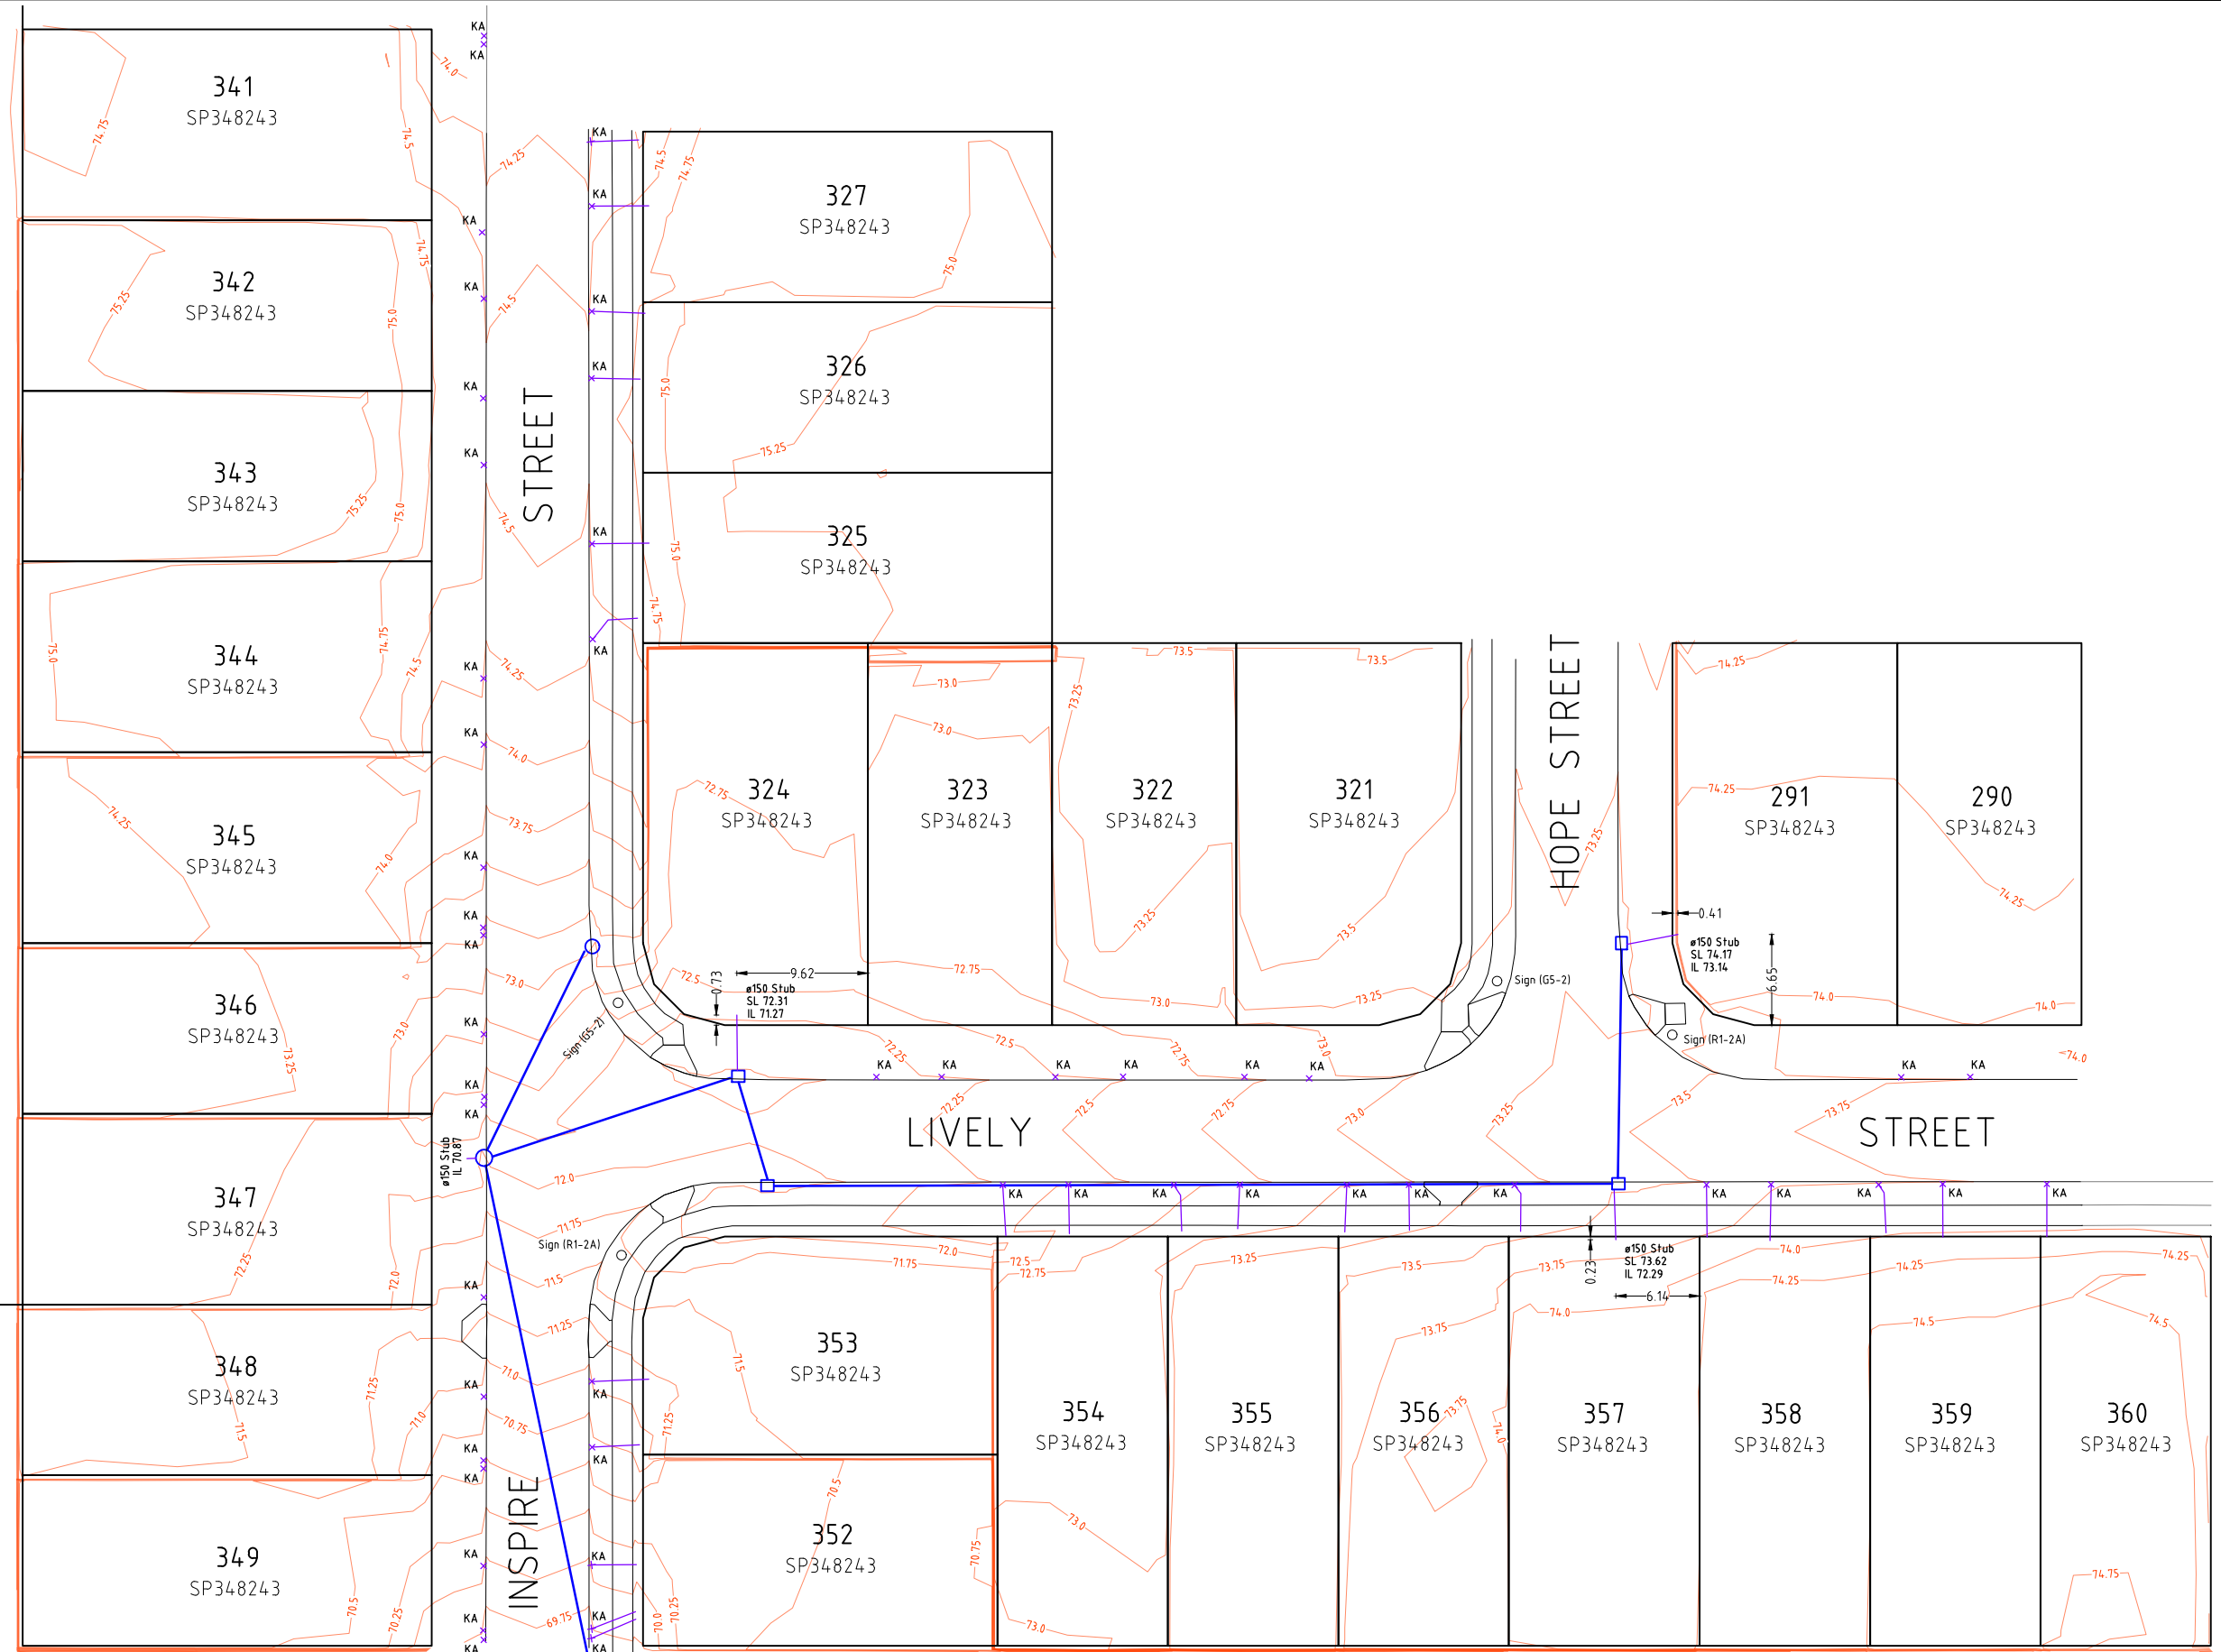

**AS CONSTRUCTED**

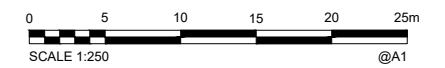

<b>A1</b>						
	A	23/01/2025	Builder's Issue			
INDEX	DATE	REVISIONS	DRAWN	CHECKED	PASSED	

DRAWN	CH	19.12.2024
CHECKED	CU	17.01.2025
PASSED		
INITIALS	DATE	

**saunders havill group**  
 Brisbane Springfield  
 head office 9 Thompson St Bowen Hills Q 4006  
 phone 1300 423 515 web www.saundershavill.com  
 Drawing No: 9780 S 78 AC A

**Colliers INTERNATIONAL**

**City of Ipswich**

**IPSWICH CITY COUNCIL**  
 AS CONSTRUCTED - ROADS & DRAINAGE  
 BELLEVUE ESTATE - STAGE 13  
 LIVELY STREET, RIPLEY

SCALE	1:250
SHEET	1 OF 1 SHEETS
DRAWING NO.	