

★ The SL of house connections for lots in future stages are not final.

A1

REV NO	DATE	REVISION PURPOSE / DESCRIPTION	DRAWN	RPEQ	RPEQ No
A	Prelim	Builders Issue			


DRAWN	CM	19.03.2025
CHECKED	CU	19.03.2025
APPROVED		

SH saunders havill group
 Saunders Havill Group Pty Ltd ABN 24 144 992 949
 head office 9 Thompson St Bowen Hills Q 4006
 phone 080 623 SHG web www.saundershavill.com
 ■ surveying ■ town planning ■ urban design ■ environmental management ■ landscape architecture
 Drawing No: 9780 S 80 AC A

UrbanUtilities

BELLEVUE ESTATE - STAGE 15
SUNNY CRESCENT, RIPLEY
PLAN OF ADAC SURVEY DATA
SEWERAGE RETICULATION 23-PNT-67468

DRAWING STATUS AS CONSTRUCTED	
SHEET 1 OF 4 SHEETS	
DRAWING NO.	REV. A

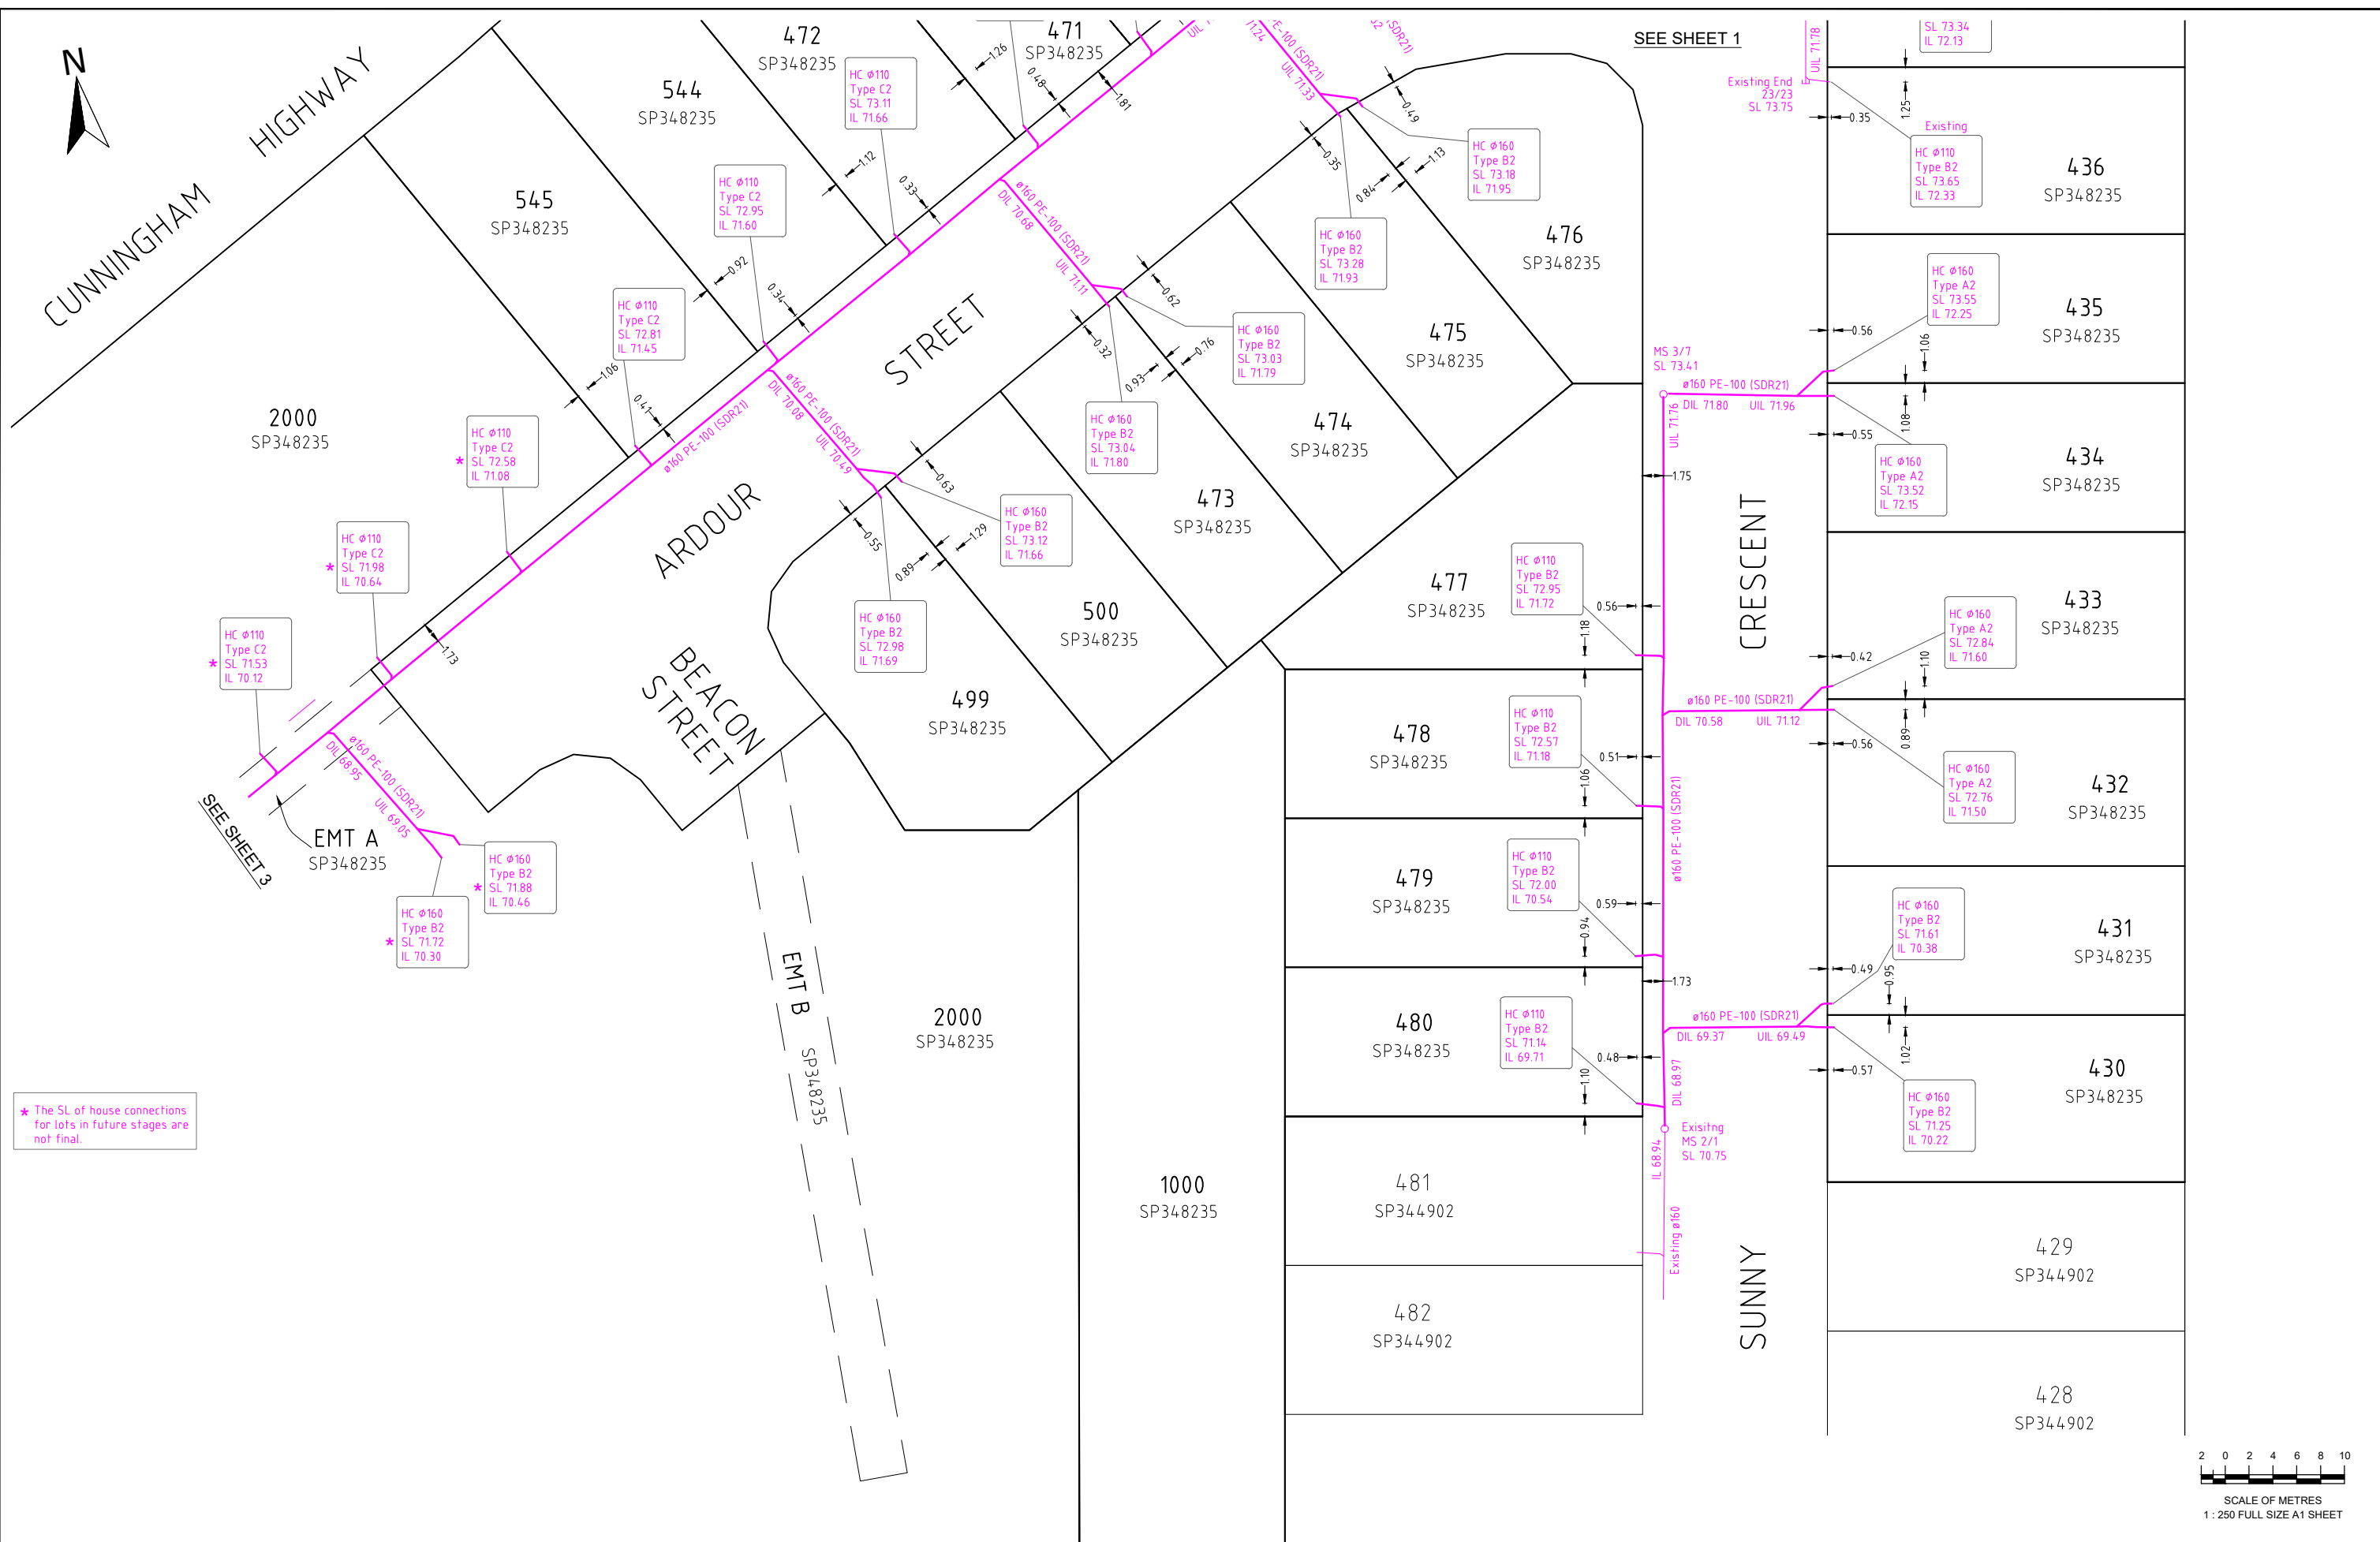

* The SL of house connections for lots in future stages are not final.

A1

REV NO	DATE	REVISION PURPOSE / DESCRIPTION	DRAWN	RPEQ	RPEQ No
A	Prelim	Builders Issue			


DRAWN	CM	19.03.2025
CHECKED	CU	19.03.2025
APPROVED		

SH saunders havill group
 Saunders Havill Group Pty Ltd ABN 24 144 992 949
 head office 9 Thompson St Bowen Hills Q 4006
 phone 0800 683 SHG web www.saundershavill.com
 ■ surveying ■ town planning ■ urban design ■ environmental management ■ landscape architecture

UrbanUtilities

BELLEVUE ESTATE - STAGE 15
SUNNY CRESCENT, RIPLEY
 PLAN OF ADAC SURVEY DATA
 SEWERAGE RETICULATION 23-PNT-67468


DRAWING STATUS AS CONSTRUCTED	
SHEET 2 OF 4 SHEETS	
DRAWING NO.	REV. A

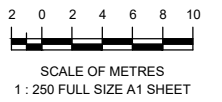



WATER FITTINGS LEGEND

- Hydrant
- Valve
- Bend
- Water Fitting
- Dead End Cap
- Reducer
- WM
- Conduit Crossing and Service Pipe

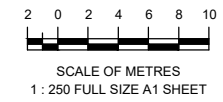

SEE SHEET 2

A1									

DRAWN	CM	19.03.2025
CHECKED	CU	19.03.2025
APPROVED		

SH saunders havill group
 Saunders Havill Group Pty Ltd ABN 24 144 992 949
 head office 9 Thompson St Bowen Hills Q 4006
 phone: 800 823 SHG web: www.saundershavill.com
 ■ surveying ■ town planning ■ urban design ■ environmental management ■ landscape architecture



BELLEVUE ESTATE - STAGE 15
SUNNY CRESCENT, RIPLEY
 PLAN OF ADAC SURVEY DATA
 WATER RETICULATION 23-PNT-67468

DRAWING STATUS	
AS CONSTRUCTED	
SHEET 1 OF 2 SHEETS	
DRAWING NO.	REV.
	A

