


A1																																																																																																																																																																																																																																																																																																																																																																																																																																																																																																																																																																																																																																																																																																																																																																																																																																																																																																																																																																																																																																																																																																																																																																																																																																																																																																																																																																																																																												
----	--	--	


A1											 BOWEN HILLS SPRINGFIELD 1300 123 744 mail@saundershavill.com		BELLEVUE ESTATE - STAGE 16 GLADDEN STREET, RIPLEY		DRAWING STATUS <u>AS CONSTRUCTED</u>		
													SHEET 2 OF 2 SHEETS				
															DRAWING NO.	REV.	
	A	31.07.2025	Builders Issue											PLAN OF ADAC SURVEY DATA SEWERAGE RETICULATION 24-PNT-75099			A
	REV NO	DATE	REVISION PURPOSE / DESCRIPTION			DRAWN	RPEQ	RPEQ No		INITIALS			DATE				
									DRAWN	CM	25.07.2025						
									CHECKED	CU	28.07.2025						
									APPROVED								

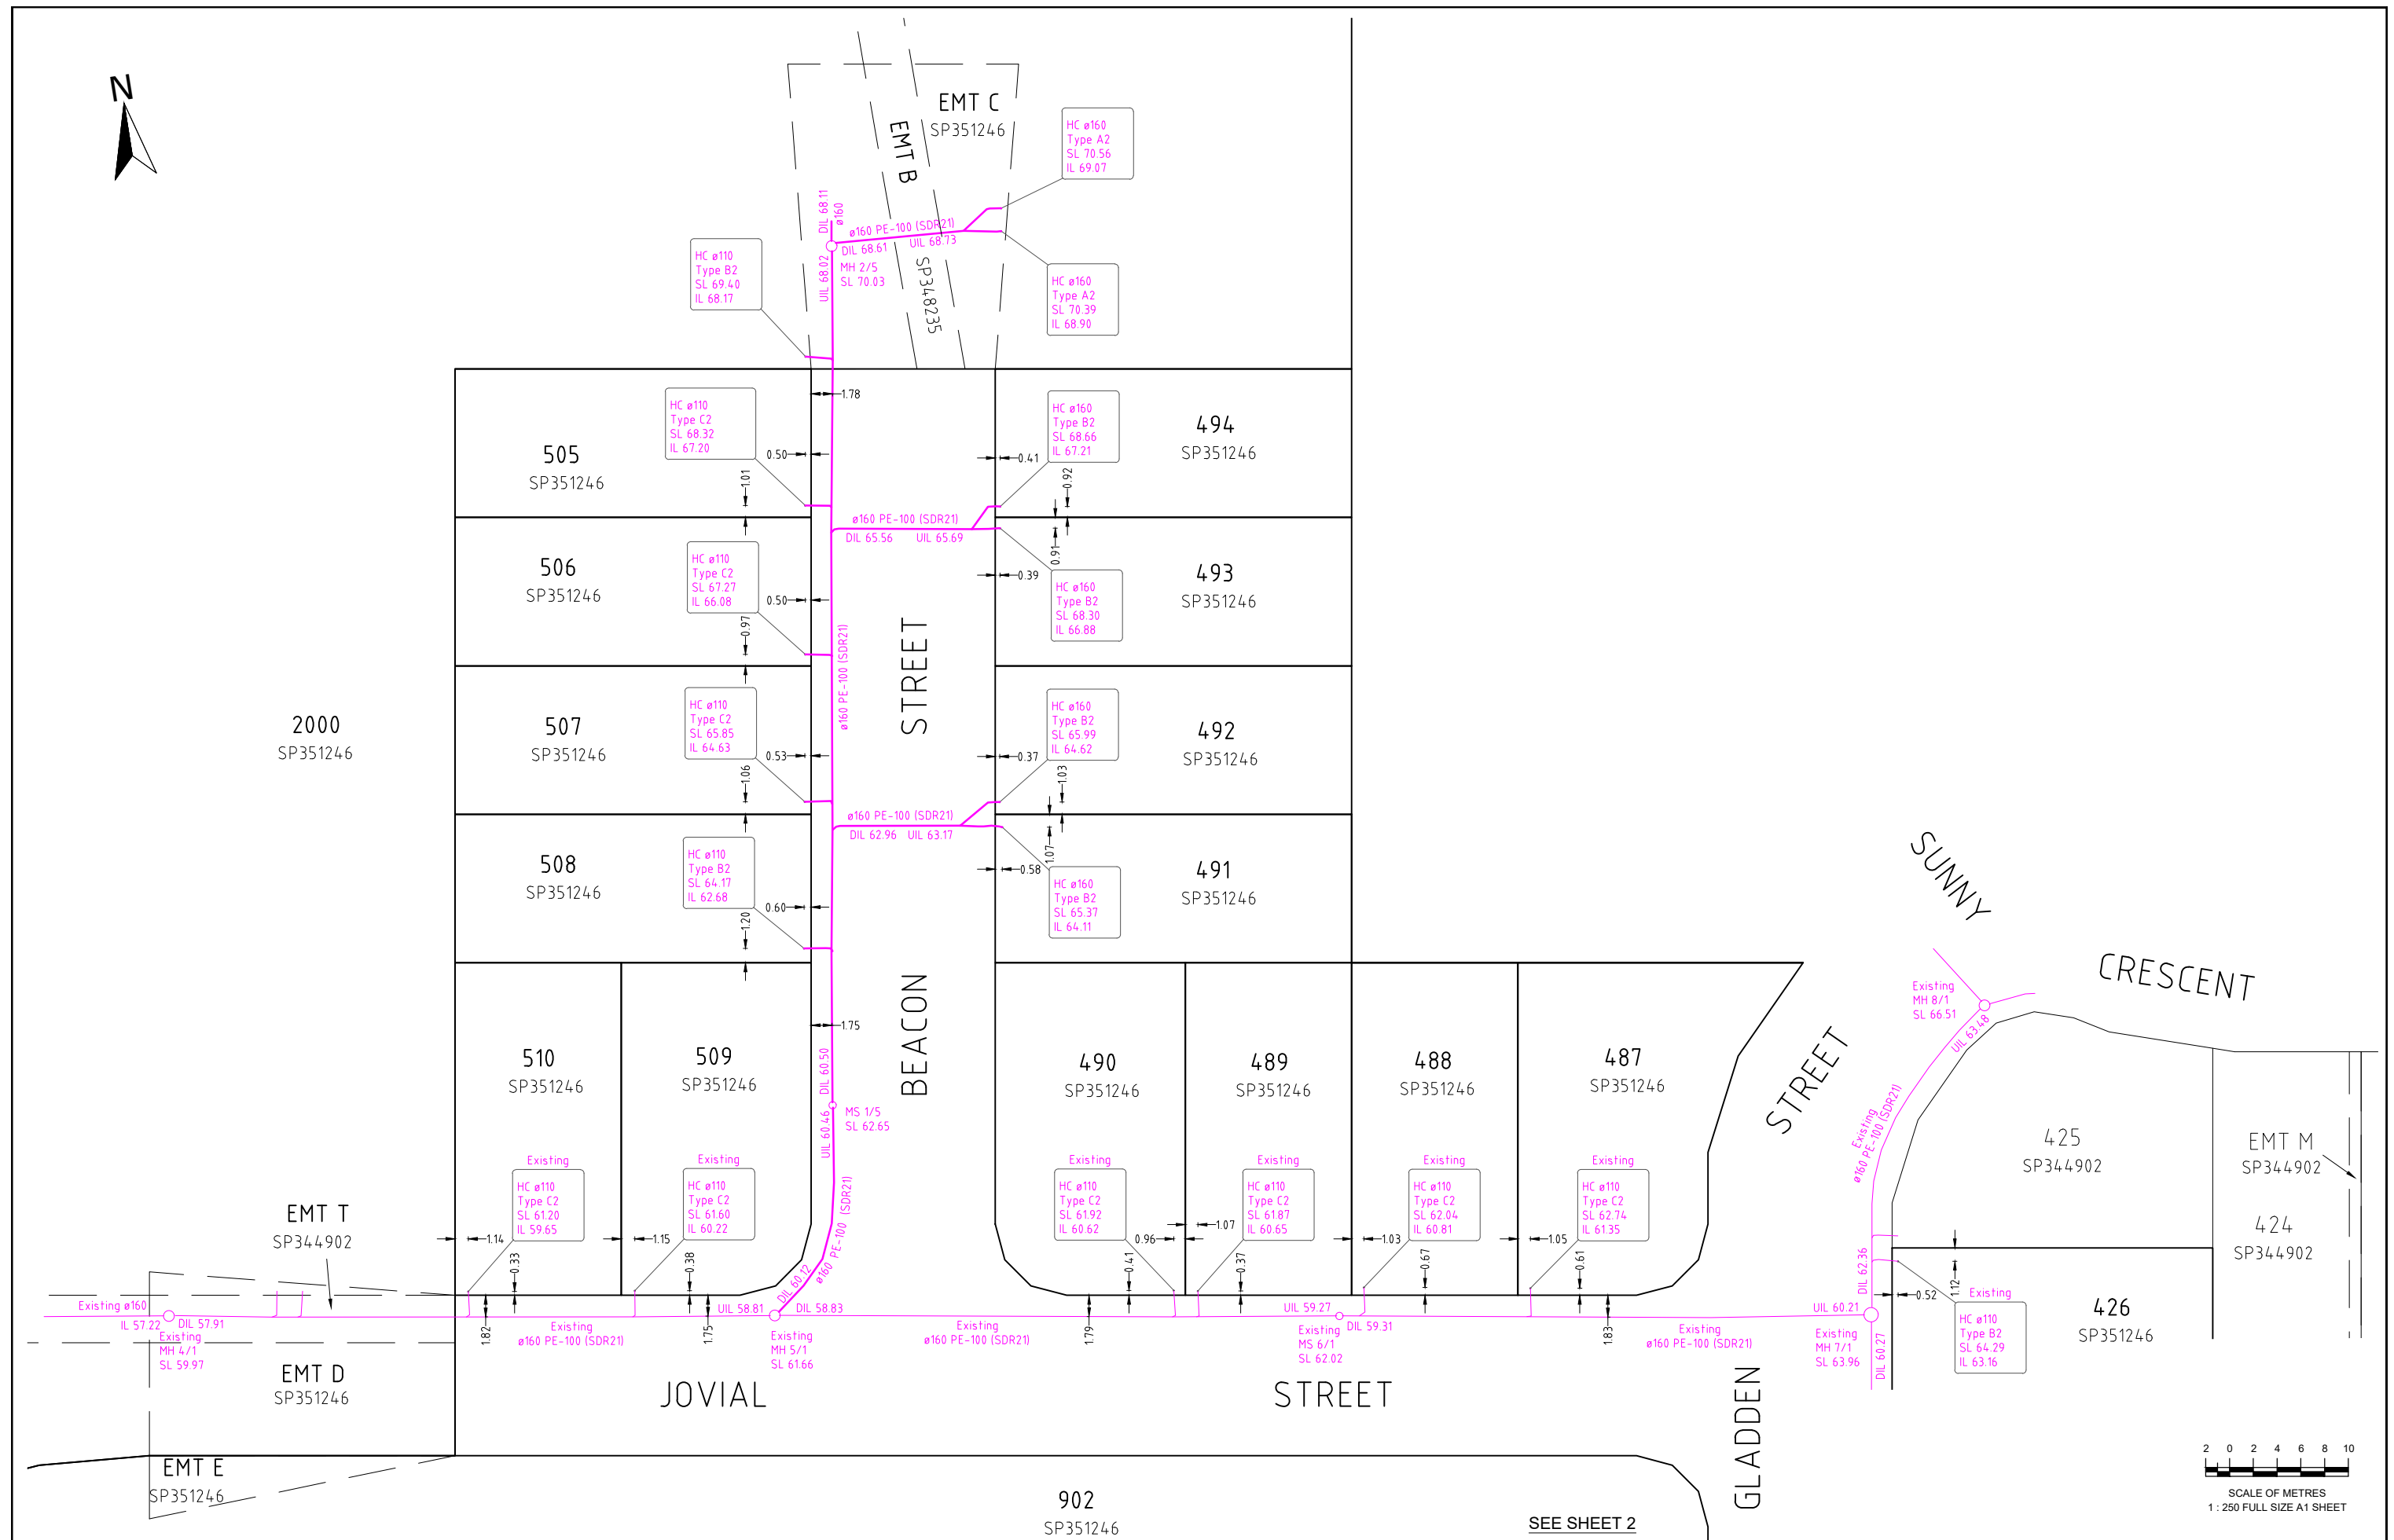