


SEE SHEET 2

AS CONSTRUCTED

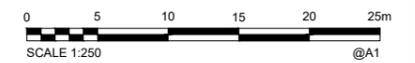

A1								
	A	19/02/2026	Builder's Issue					
INDEX	DATE	REVISIONS	DRAWN	CHECKED	PASSED			

DRAWN	CH	16.02.2026
CHECKED	CU	19.02.2026
PASSED		
INITIALS	DATE	


Saunders Havill
 BOWEN HILLS | SPRINGFIELD
 1300 123 744 | mail@saundershavill.com
 Drawing No: 9780 S 91 AC A

Colliers INTERNATIONAL


City of Ipswich

IPSWICH CITY COUNCIL
 AS CONSTRUCTED - ROADS & DRAINAGE
 BELLEVUE ESTATE - STAGE 17
 ARDOUR STREET, RIPLEY

SCALE	1:250
SHEET	1 OF 2 SHEETS
DRAWING NO.	

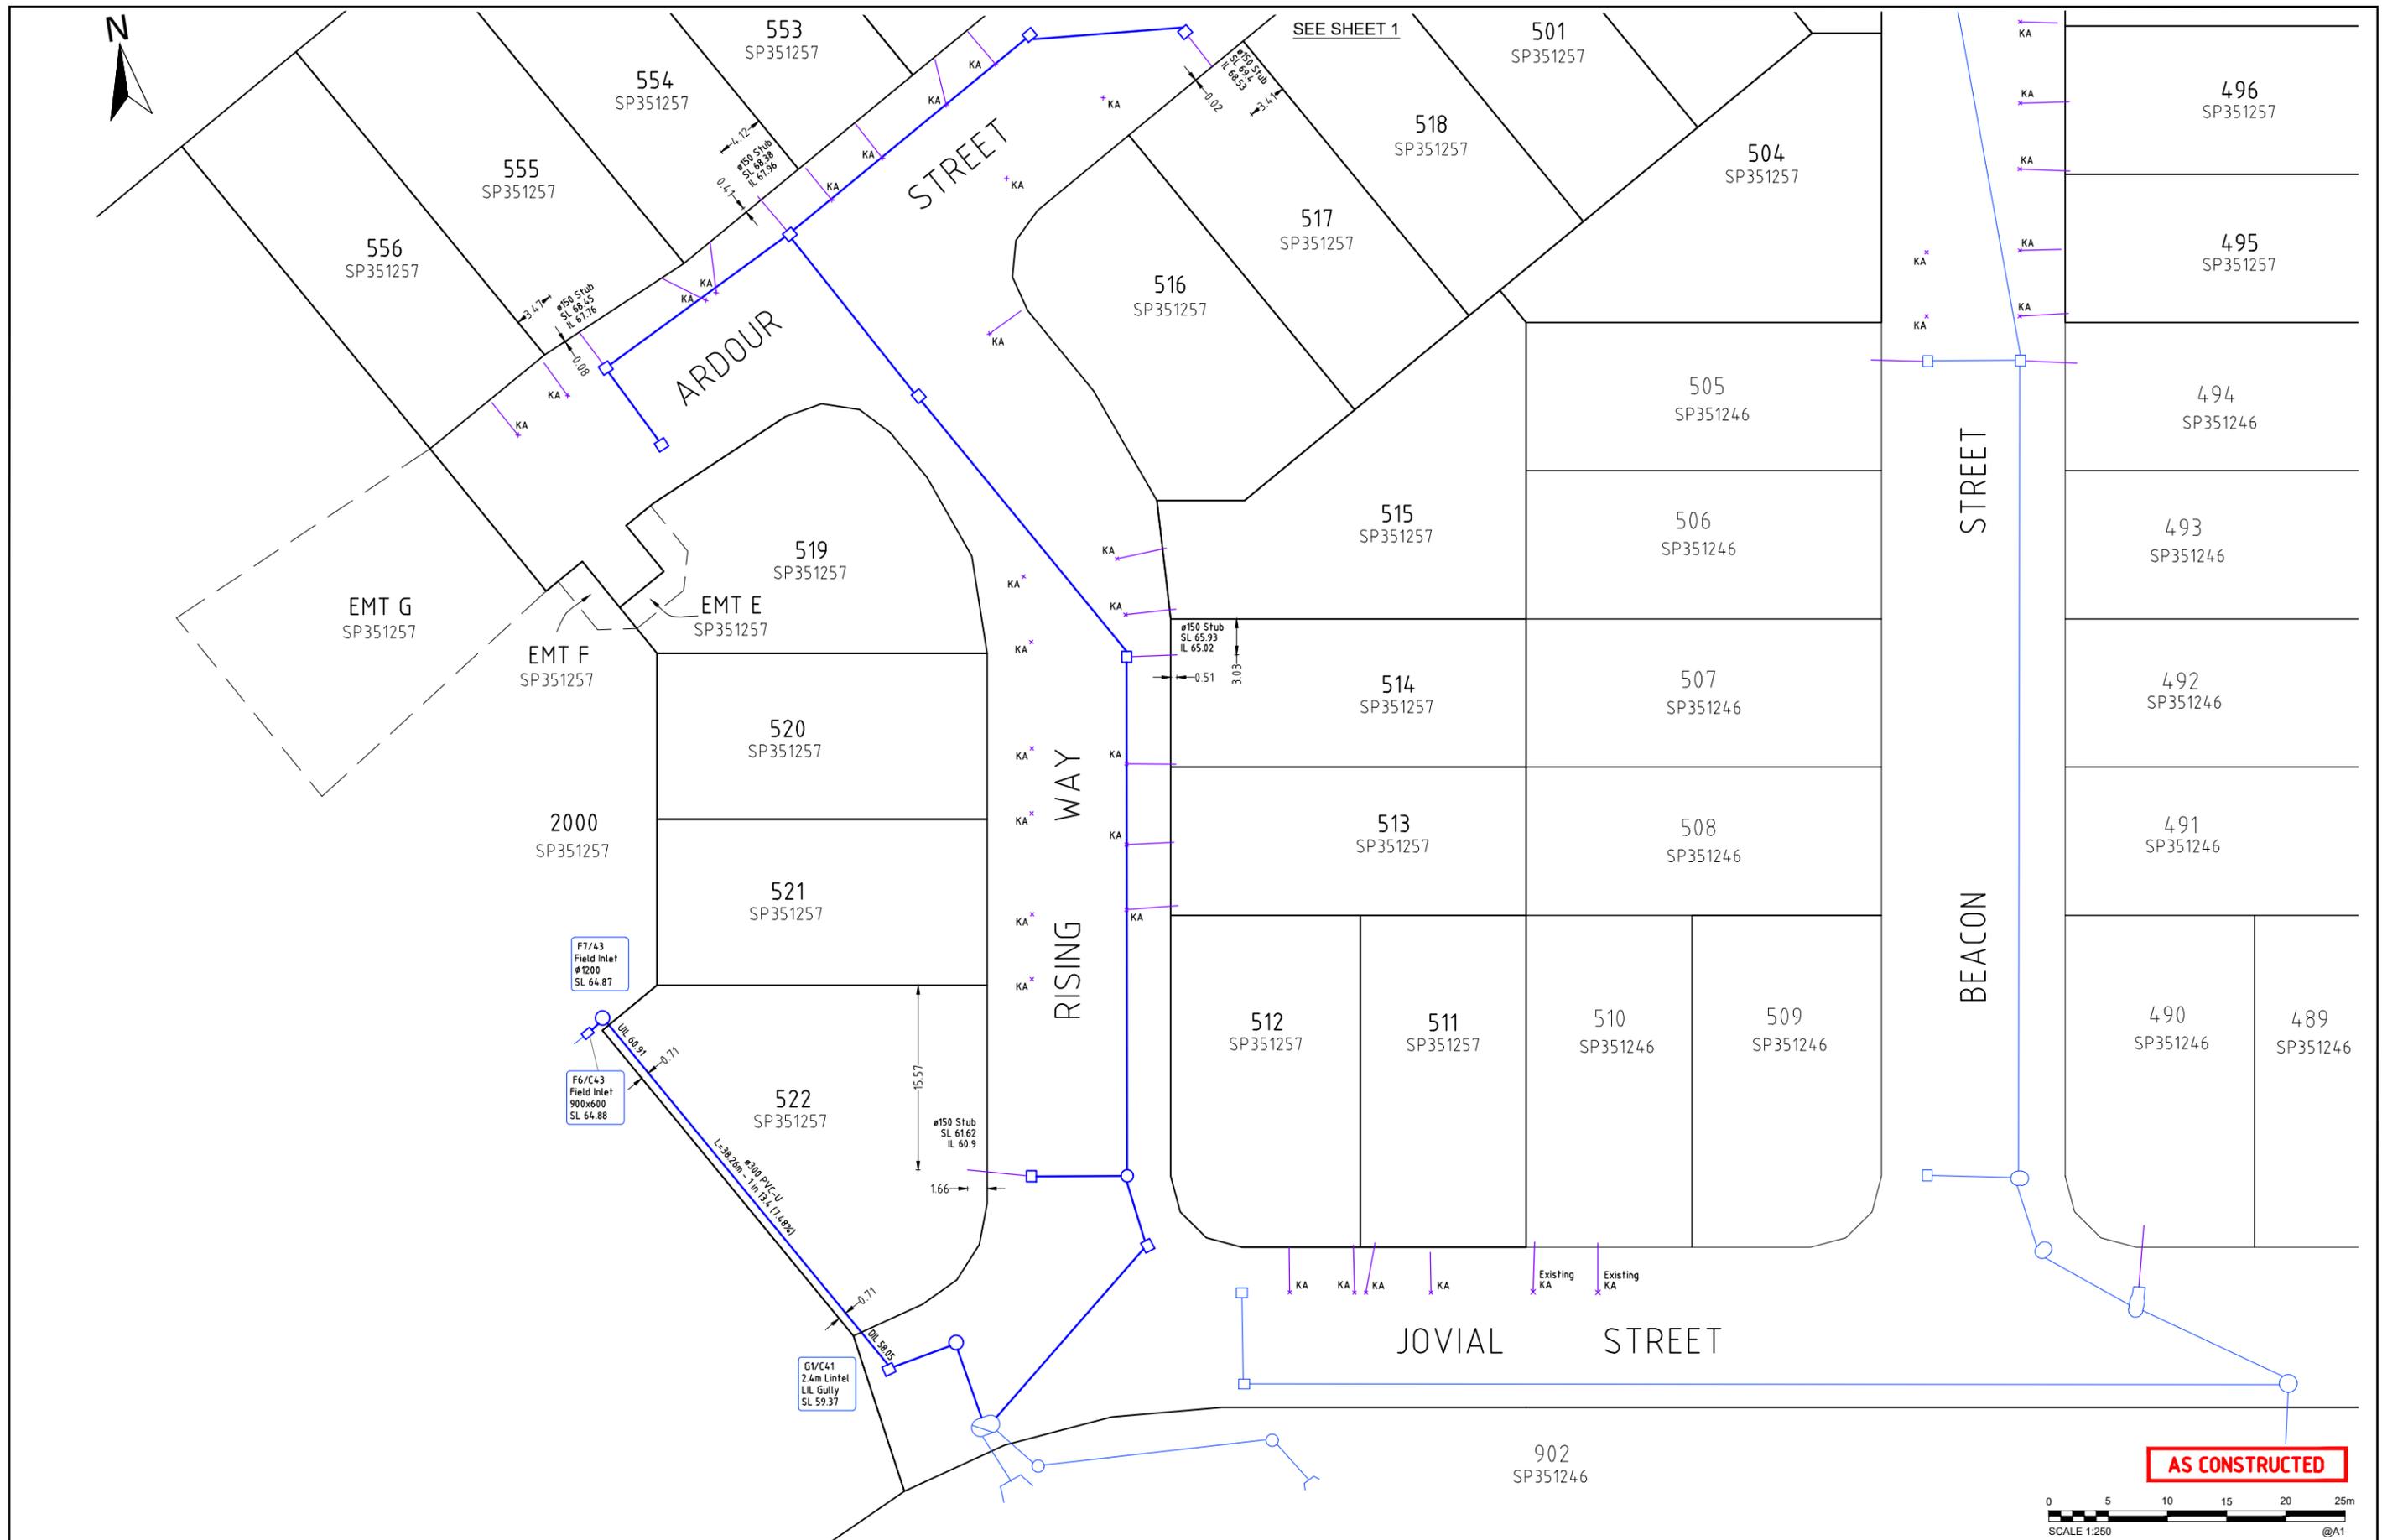


AS CONSTRUCTED

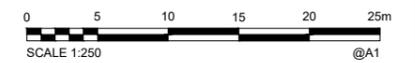

A1	INDEX	DATE	REVISIONS	DRAWN	CHECKED	PASSED
	A	19/02/2026	Builders Issue			

DRAWN	CH	16.02.2026
CHECKED	CU	19.02.2026
PASSED		
INITIALS	DATE	

Saunders Havill
 BOWEN HILLS | SPRINGFIELD
 1300 123 744 | mail@saundershavill.com
 Drawing No: 9780 S 91 AC A

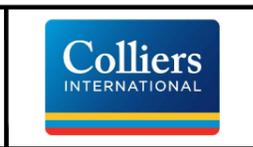

IPSWICH CITY COUNCIL
 AS CONSTRUCTED - ROADS & DRAINAGE
 BELLEVUE ESTATE - STAGE 17
 ARDOUR STREET, RIPLEY

SCALE	1:250
SHEET	2 OF 2 SHEETS
DRAWING NO.	