



A1

REV NO	DATE	REVISION PURPOSE / DESCRIPTION	DRAWN	RPEQ	RPEQ No
A	08.05.2026	Builders Issue			

DRAWN	CM	27.04.2026
CHECKED	CU	01.05.2026
APPROVED		
INITIALS		DATE

**Saunders Havill**  
BOWEN HILLS | SPRINGFIELD  
1300 123 744 | mail@saundershavill.com

**UrbanUtilities**

BELLEVUE ESTATE - STAGE 18  
ARDOUR STREET, RIPLEY  
AS CONSTRUCTED  
SEWERAGE RETICULATION 24-PNT-7561

DRAWING STATUS	
<b>AS CONSTRUCTED</b>	
SHEET 1 OF 3 SHEETS	
DRAWING NO.	REV.
	A

2 0 2 4 6 8 10  
SCALE OF METRES  
1 : 250 FULL SIZE A1 SHEET



**A1**

REV NO	DATE	REVISION PURPOSE / DESCRIPTION	DRAWN	RPEQ	RPEQ No
A	08.05.2026	Builders Issue			

DRAWN	CM	27.04.2026
CHECKED	CU	01.05.2026
APPROVED		


**Saunders Havill**  
BOWEN HILLS | SPRINGFIELD  
1300 123 744 | mail@saundershavill.com

**UrbanUtilities**


BELLEVUE ESTATE - STAGE 18  
ARDOUR STREET, RIPLEY  
AS CONSTRUCTED  
SEWERAGE RETICULATION 24-PNT-7561

DRAWING STATUS	
<b>AS CONSTRUCTED</b>	
SHEET 2 OF 3 SHEETS	
DRAWING NO.	REV.
	A

Drawing No: 9780 S 92 AC A

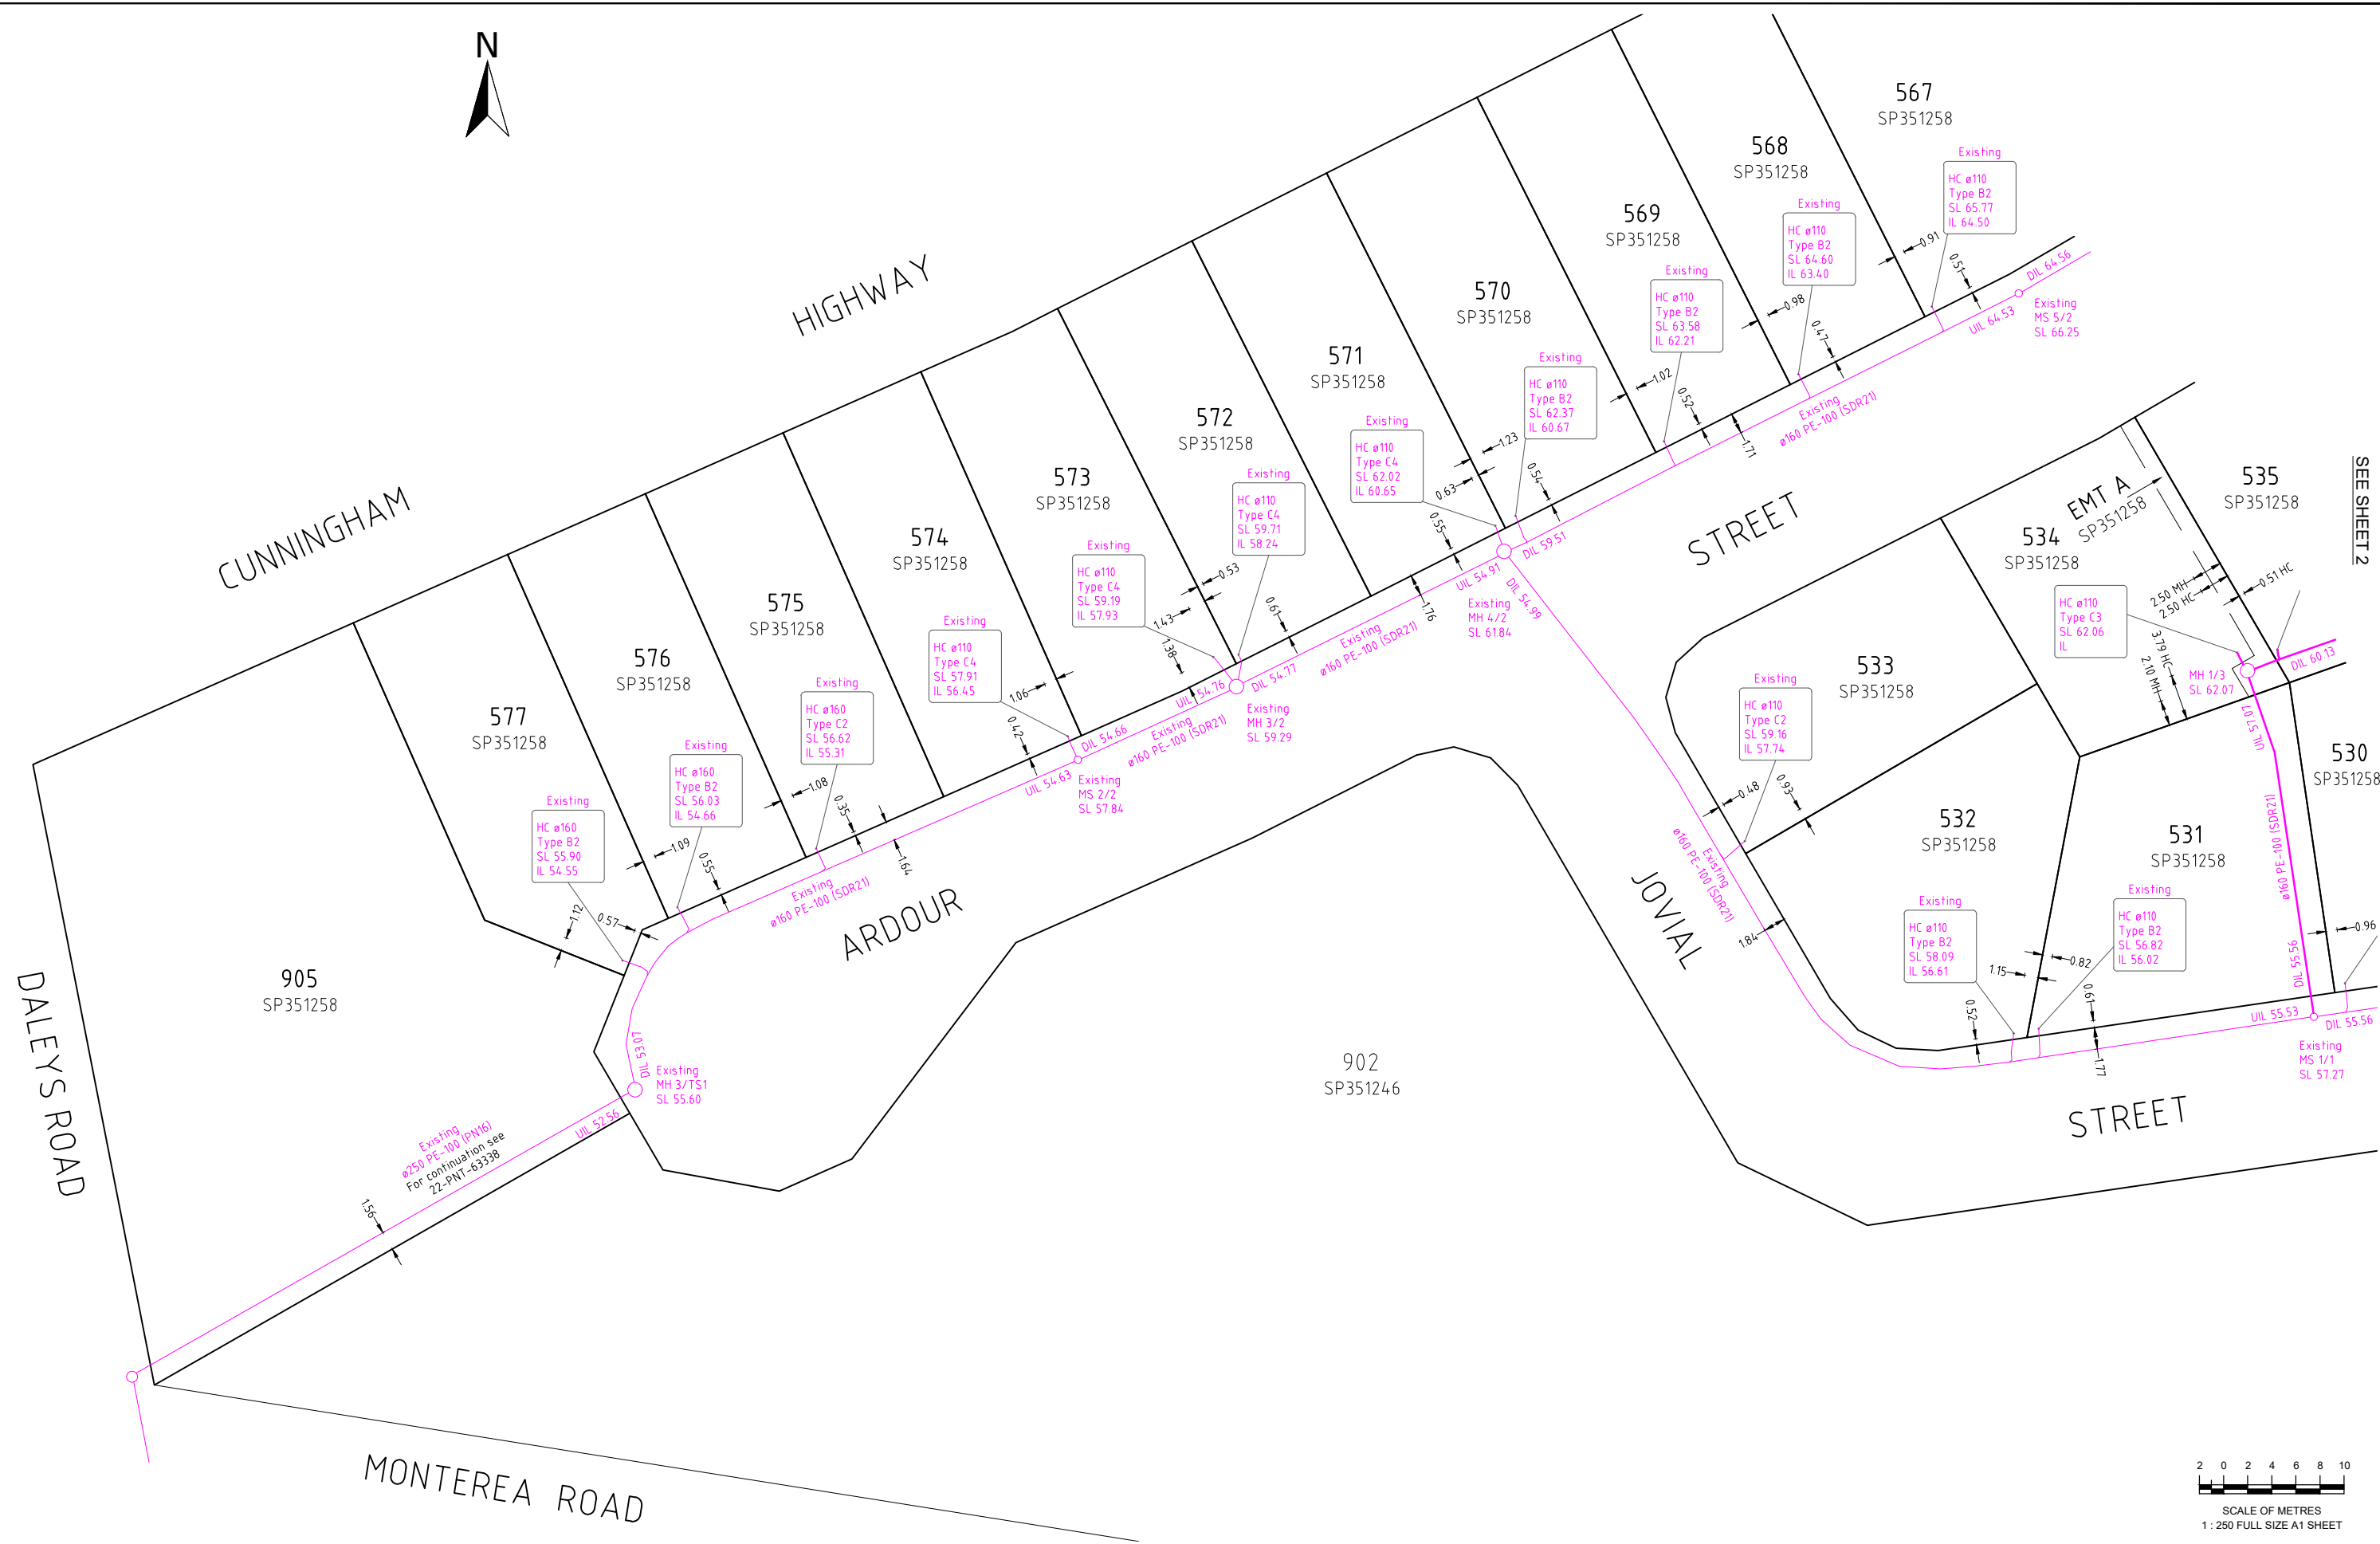

SEE SHEET 2

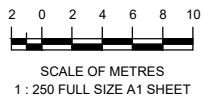

**A1**

REV NO	DATE	REVISION PURPOSE / DESCRIPTION	DRAWN	RPEQ	RPEQ No
A	08.05.2026	Builders Issue			

DRAWN	CM	27.04.2026
CHECKED	CU	01.05.2026
APPROVED		
INITIALS	DATE	

**Saunders Havill**  
BOWEN HILLS | SPRINGFIELD  
1300 123 744 | mail@saundershavill.com

**UrbanUtilities**

BELLEVUE ESTATE - STAGE 18  
ARDOUR STREET, RIPLEY  
AS CONSTRUCTED  
SEWERAGE RETICULATION 24-PNT-7561

DRAWING STATUS	
<b>AS CONSTRUCTED</b>	
SHEET 3 OF 3 SHEETS	
DRAWING NO.	REV.
	A


Drawing No: 9780 S 92 AC A



WATER FITTINGS LEGEND	
	Hydrant
	Valve
	Bend
	Water Fitting
	Dead End Cap
	Reducer
	Water Meter
	Conduit Crossing and Service Pipe



SEE SHEET 2

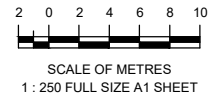

A1

REV NO	DATE	REVISION PURPOSE / DESCRIPTION	DRAWN	RPEQ	RPEQ No
A	08.05.2026	Builders Issue			

DRAWN	CM	27.04.2026
CHECKED	CU	01.05.2026
APPROVED		
INITIALS		DATE



**Saunders  
Havill**  
BOWEN HILLS | SPRINGFIELD  
1300 123 744 | mail@saundershavill.com

Drawing No: 9780 S 92 AC A




BELLEVUE ESTATE - STAGE 18  
ARDOUR STREET, RIPLEY  
AS CONSTRUCTED  
WATER RETICULATION 24-PNT-7561

DRAWING STATUS <b>AS CONSTRUCTED</b>	
SHEET 1 OF 3 SHEETS	
DRAWING NO.	REV. A



WATER FITTINGS LEGEND	
	Hydrant
	Valve
	Bend
	Water Fitting
	Dead End Cap
	Reducer
	Water Meter
	Conduit Crossing and Service Pipe

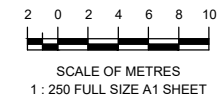

**A1**

REV NO	DATE	REVISION PURPOSE / DESCRIPTION	DRAWN	RPEQ	RPEQ No
A	08.05.2026	Builders Issue			

DRAWN	CM	27.04.2026
CHECKED	CU	01.05.2026
APPROVED		
INITIALS		DATE

**Saunders Havill**  
BOWEN HILLS | SPRINGFIELD  
1300 123 744 | mail@saundershavill.com

**UrbanUtilities**

BELLEVUE ESTATE - STAGE 18  
ARDOUR STREET, RIPLEY  
AS CONSTRUCTED  
WATER RETICULATION 24-PNT-7561

DRAWING STATUS <b>AS CONSTRUCTED</b>	
SHEET 2 OF 3 SHEETS	
DRAWING NO.	REV. A


Drawing No: 9780 S 92 AC A



SEE SHEET 2

**WATER FITTINGS LEGEND**

	Hydrant
	Valve
	Bend
	Water Fitting
	Dead End Cap
	Reducer
	Water Meter
	Conduit Crossing and Service Pipe

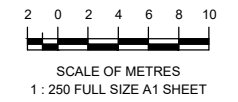

**A1**

REV NO	DATE	REVISION PURPOSE / DESCRIPTION	DRAWN	RPEQ	RPEQ No
A	08.05.2026	Builders Issue			

DRAWN	CM	27.04.2026
CHECKED	CU	01.05.2026
APPROVED		
INITIALS		DATE

**Saunders Havill**  
BOWEN HILLS | SPRINGFIELD  
1300 123 744 | mail@saundershavill.com

**UrbanUtilities**

BELLEVUE ESTATE - STAGE 18  
ARDOUR STREET, RIPLEY  
AS CONSTRUCTED  
WATER RETICULATION 24-PNT-7561

DRAWING STATUS <b>AS CONSTRUCTED</b>	
SHEET 3 OF 3 SHEETS	
DRAWING NO.	REV.
	A

Drawing No: 9780 S 92 AC A